

MISSISSIPPI DEPARTMENT OF NATURAL RESOURCES

Bureau of Land and Water Resources

P.O. Box 10631

Jackson, Mississippi 39209

WATER WELL DRILLERS LOG

COUNTY WELL LOCATED

HALL *W. A. Hines*

WELL NUMBER **C** CODED

DATE WELL COMPLETED **2000 4-2-94**

PERMIT NUMBER

NAME OF DRILLING FIRM
Houston

NAME & MAILING ADDRESS OF LANDOWNER

MIKE SWINDOL

Tutwiler

WELL LOCATION: SEC **32** TOWNSHIP **25** RANGE **8**
S **W**

DISTANCE _____ MILES _____ of _____

OTHER LANDMARK

WELL PURPOSE: Home, Irrigation, Municipal, Industrial, Fish Pond, etc.

PUMP DATA

PUMP TYPE (Circle One):
Submersible, **Turbine**, Jet, Flowing Well,
Other (Describe) _____

POWER TYPE (Circle One):
Electric, Tractor, Diesel, Gasoline, Butane,
Other (Describe) _____ H/P _____

Pump Capacity (GPM) **1500** No. of Stages **2** Setting Depth **50** FT.

PUMP TEST
Well yielded **1500** GPM with
a drawdown of _____ ft.
after _____ hours of pumping

WELL DATA

Well Depth **108'** Casing Diameter (In.) **16"** Casing Length (Ft.) **68'**

Type of Casing **steel** Hole Depth **108'** Depth to Static Water Level _____

TYPE OF COMPLETION: (Circle One or More):
Gravel Packed, Underreamed, Telescoped,
Natural Development, Open Hole, Other _____

Top of Lap Pipe or Reduction in Casing _____
FEET IF TELESCOPED OR MORE THAN ONE SCREEN: USE BACK PAGE

LOG DATA

TYPE OF LOG RUN (Circle One):
No Log Run, Electric, Gamma Ray, Density, Sonic, Neutron,
Other (Describe) _____

Name of Organization Running Log

GEOLOGIC DATA (Office Use Only)

Surface Elev. _____ Geologic Unit: _____ Unit Thickness _____ Depth to Top _____
Subs. SW Date _____ Dept. of Environmental Quality
Office of Land & Water Resources

Driller's Remarks

SCREEN DATA

Diameter - Inches **16"** Length - Feet **40** Slot Size - Inches _____


Screen Type **wire wrapped** Depth to Bottom - Feet _____

DESCRIPTION OF FORMATIONS ENCOUNTERED	FROM	TO	FORMATIONS (Continued)	FROM	TO
Clay	0	10			
Clay	10	20			
Clay	20	30			
Clay & F. sand	30	40			
M. Sand & gravel	40	50			
Gravel	50	60			
Gravel	60	70			
Gravel	70	80			
Gravel	80	90			
Gravel	90	100			
Gravel	100	108			

IF MORE SPACE IS NEEDED, USE BACK

RECEIVED

scopes please
and show depths.

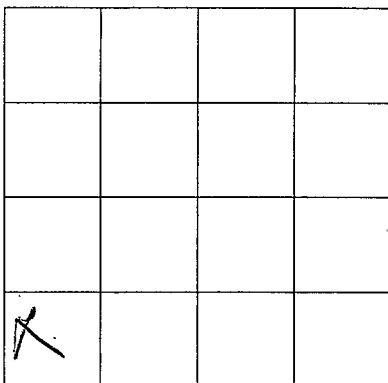

SECTION _____

Please indicate well location X.

ADDITIONAL INFORMATION

A series of horizontal lines for additional information.

ne screen,
of each on sketch.