


MISSISSIPPI BOARD OF WATER COMMISSIONERS

WATER WELL DRILLERS LOG

Date: \_\_\_\_\_, 19\_\_\_\_, Driller: Luther Pettif County \_\_\_\_\_  
 (When well drilled) (Name) (Where well is located)

(1) Owner of Land: (Name)	Description & Color of Materials Sand, Clay, Red Clay, Shell, etc.	Thick- ness Feet	Depth Feet
_____ (Address)	<u>643-663 sand</u>		
(2) Location: _____ 1/4, _____ 1/4, Sec. _____ T. R. _____	<u>663-683 sand + shale</u>		
_____ miles _____ of _____ (distance) (direction) (Nearest Town)	<u>683-703 shale</u>		
(3) Topography: _____ (Hilly) (Flat) (Level)	<u>703-723 shale</u>		
(4) Purpose of Well: _____ (Domestic Irrigation Municipal, Industrial, Other)	<u>723-743 shale + sand</u>		
Information upon completion of well:	<u>743-763 sand</u>		
(1) Diameter <u>4x2</u> inches.	<u>763-783 sand + shale</u>		
(2) Total Depth <u>1048</u> feet.	<u>783-803 shale + sand streak</u>		
(3) Water Level <u>15</u> feet below top of ground.	<u>803-823 shale</u>		
(4) Cased to <u>1048</u> , Size <u>4x2</u>	<u>823-843 shale + sand</u>		
(5) Screen: Size <u>12 slot</u> , Length <u>20'</u>	<u>843-863 shale</u>		
(6) Were any formations sealed against pollution? _____ yes, _____ no.	<u>863-883 shale</u>		
If YES depth of formation _____	<u>883-907 sand</u>		
Why _____	<u>903-923 Gumbo</u>		
Drillers Remarks: _____	<u>923-943 sand + shale streak</u>		
Yield in gpm: _____	<u>943-963 sand</u>		
Size pump: _____	<u>963-983 sand</u>		
Type power: _____	<u>983-1007 sand</u>		
	<u>1003-1023 sand</u>		
	<u>1023-1048 sand</u>		

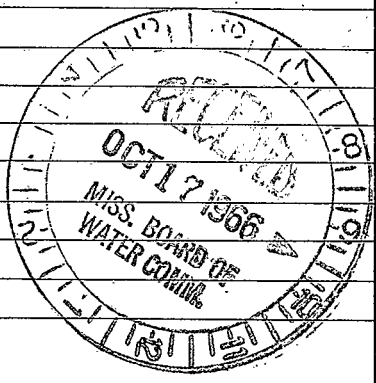

Mail this copy to Board of Water Commissioners 429 Miss. St. Jackson, Miss.

14"

126 feet

2"

922

2"

20

3 Steel  
Screen