

Zallahatchie
D5
3-12-69

MISSISSIPPI
 BOARD OF WATER COMMISSIONERS
 416 North State Street
 Jackson, Mississippi 39201

CODED

WATER WELL DRILLERS LOG

3-12 1969 Five County Farmers Union Zallahatchie
 date well completed firm name county well located

LANDOWNER: T B ABBEY
SUMNER MISS

description of formations encountered	from	to
Clay	0	18
Sand	18	86.4
Small Red gravel	86.4	144
Clay	144	175
sand & lignite	175	192
Clay	192	269
sand & lignite	269	302
Clay	302	350
Rock	350	358
Clay & Red streaks	358	385
Clay	385	414
7' Rock	414	414.3
Clay	414.3	420.9
6" Rock	420.9	421.3
clay	421.3	460
8" Rock	460	460.8
Clay	460.8	652
Manganese Sand	652	731.1

(mailing address)

WELL LOCATION:
 sec. 26 T. 25 N R. 12 W
6 miles NE of Sumner
 (distance) (direction) (nearest town)

WELL PURPOSE: Domestic
 (home, irrigation, municipal, industrial)

- WELL COMPLETION DATA:
- (1) diameter (inches) 4 x 2 1/2
 - (2) total depth (feet) 724
 - (3) static water level (feet) 26 ^{below} above top of ground.
 - (4) casing Sched 40 Pipe 694'
 (material) (depth)
 - 4 x 2 1/2 If telescope see back.
 (size)
 - (5) screen 30 694
 (length) (depth to top)
 - 2 1/2 Stainless steel
 (size) (material)
 - (6) pump 1 20
 (HP) (yield gpm)
 - Elec
 (type power)
 - (7) electric log NO
 (yes or no)
 - (organization running log)
 - (8) how well bottom plugged wash valve

CODED

DRILLERS REMARKS:

MAR 17 1969


If well telescopes please sketch and show depths.

GROUND LEVEL

147'
84'

547'
2 1/2'

30' 55' screen
2 1/2'
1' well pipe

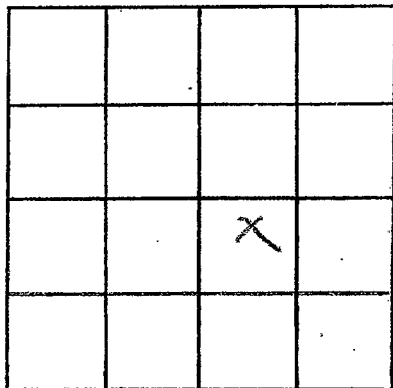

SECTION 26

Please indicate well location X.

ADDITIONAL INFORMATION

Well depth 547'
Old well on
opposite Bayou
Old well logged
33 in State Book

If more than one screen, show locations of each on sketch.