

Zallahatchie

MISSISSIPPI BOARD OF WATER COMMISSIONERS

D6

5-6-66

James Ray Line  
WATER WELL DRILLERS LOG

CODED

Zallahatchie

Date: 5-6, 1966, Driller: Frank Heyford County Panola  
(Name)

(1) Owner of Land: Carl Campbell  
(Name)  
Brazill, Miss  
(Address)

(2) Location: 1/4, 1/4, Sec 23 T 25 N R 1 W  
1 miles east of Brazill  
(distance) (direction) (Nearest Town)

(3) Topography: level  
(Hilly) (Flat) (Level)

(4) Purpose of Well: Domestic  
(Domestic Irrigation  
Municipal, Industrial, Other)

Description & Color of Materials Sand, Clay, Red Clay, Shell, etc.	Thick- ness Feet	Depth Feet
Clay	0	90
clay + sand	90	130
clay	130	200
blue clay	200	310
sand / mud	310	390
clay	390	510
clay + sand	510	600
sand	600	700
up sand	700	760

Information upon completion of well:

(1) Diameter 2 inches.

(2) Total Depth 760 feet.

(3) Water Level flowing feet below top of ground.

(4) Cased to 760, Size 2"


(5) Screen: Size 2 1/4", Length 6'

(6) Were any formations sealed against pollution?  
\_\_\_\_\_ yes, \_\_\_\_\_ no.

If YES depth of formation \_\_\_\_\_

Why \_\_\_\_\_

Drillers Remarks: \_\_\_\_\_

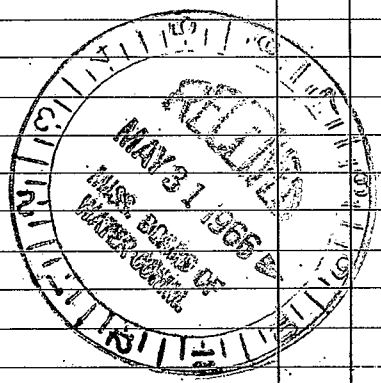

(Use Back Side)

Well No.

