

D-8  
11-6-64

WATER WELL DRILLERS LOG

**CODED**

WATER MATCH HIS

Date: 11-6-1964, Driller: Five County Farmers Lette County Everson  
(Name)

**CODED**

(1) Owner of Land: T. B. ABBEY  
(Name)

WEBB MISS  
(Address)

(2) Location: 1/4, 1/4, Sec. 18 T24 R1W

6 miles NE, of Summer  
(distance) (direction) (Nearest Town)

(3) Topography: Flat  
(Hilly) (Flat) (Level)

(4) Purpose of Well: Irrigation + Fish Lake  
(Domestic Irrigation Municipal, Industrial, Other)

Description & Color of Materials Sand, Clay, Red Clay, Shell, etc.	Thick-ness Feet	Depth Feet
<u>TOP SOIL + CLAY</u>	<u>14</u>	<u>14 1/2</u>
<u>FINE SAND</u>	<u>33</u>	<u>47 1/2</u>
<u>Coarse Grey Sand</u>	<u>13</u>	<u>60 1/2</u>
<u>Sand + Clay</u>	<u>6 1/2</u>	<u>66 1/2</u>
<u>Coarse sand + Gravel</u>	<u>41 1/2</u>	<u>107 1/2</u>
<u>- tubs of gravel -</u>		

Information upon completion of well:

(1) Diameter 6 inches.

(2) Total Depth 107 1/2 feet.

(3) Water Level 9 1/2 feet below top of ground.

(4) Cased to 61', Size 6"

(5) Screen: Size 6", Length 48"

(6) Were any formations sealed against pollution?

no yes,  no.


If YES depth of formation \_\_\_\_\_

Why \_\_\_\_\_

Drillers Remarks: \_\_\_\_\_

[Signature]

**CODED**

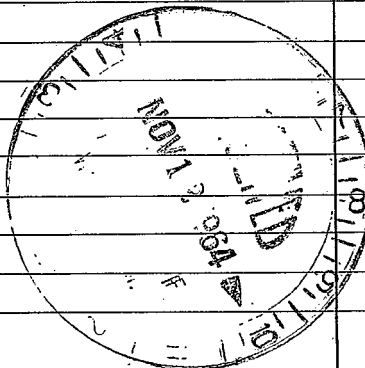

(Use Back Side)

Well No.

100

100

100

100