

TALLAHATCHIE

D 12
8-68

MISSISSIPPI BOARD OF WATER COMMISSIONERS

COULD

WATER WELL DRILLERS LOG

Date: Aug, 1966, Driller: Luther Ratliff County: Tallahatchie
(When well drilled) (Name) (Where well is located)


(1) Owner of Land: Mrs. Porter
(Name)
Brazil, Miss.
(Address)
(2) Location: NE 1/4, NE 1/4, Sec 23 T5R1W
_____ miles TOWN, of BRASIL
(distance) (direction) (Nearest Town)
(3) Topography: f
(Hilly) (Flat) (Level)
(4) Purpose of Well: Ham
(Domestic Irrigation
Municipal, Industrial, Other)

Description & Color of Materials Sand, Clay, Red Clay, Shell, etc.	Thick- ness Feet	Depth Feet
0-23 clay + sand		
23-43 sand		
43-63 sand		
63-83 sand		
83-103 sand + gravel		
103-123 gravel		
123-143 gravel + clay		
143-163 clay		
163-183 clay		
183-203 clay + sand		
203-223 sand streaks		
223-243 sand streaks		
243-263 sand + shale		
263-283 shale		
283-303 shale + sand streaks		
303-323 shale + sand streaks		
323-343 shale		
343-363 shale		
363-383 sand streaks		
383-403 sand		
403-423 sand + clay		
423-443 clay		
443-463 sand streaks		
463-483 clay		
483-503 clay		
503-523 clay		
523-543 "clay"		
543-563 sand streaks		
563-583 sand		
583-603 sand		
603-62 3/4" sand		
623-75 1/2" sand + shale		

Information upon completion of well:

(1) Diameter 4x2 inches.
(2) Total Depth 1048 feet.
(3) Water Level Flow feet below top of ground.
(4) Cased to 42 1/2, Size 4x2"
(5) Screen: Size 12, Length 20
(6) Were any formations sealed against pollution?
_____ yes, _____ no.

If YES depth of formation _____
Why _____
Drillers Remarks: _____
Yield in gpm: 8
Size pump: 1/2
Type power: Elec. Low speed pump

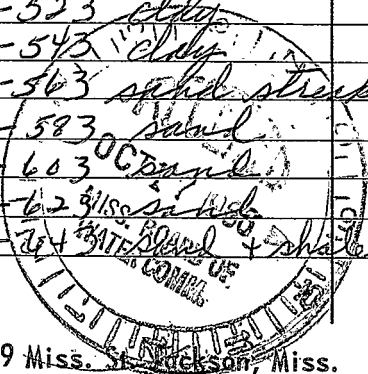

Mail this copy to Board of Water Commissioners 429 Miss. St. Jackson, Miss.

Cont'd

11

[Faint, illegible text covering the majority of the page]