

Tallahatchie
 D13
 5-67

MISSISSIPPI
 BOARD OF WATER COMMISSIONERS
 416 North State Street
 Jackson, Mississippi 39201

WATER WELL DRILLERS LOGGED

5-26 1967 Five County Farmers Club Tallahatchie
 date well completed firm name county well located

LANDOWNER: Frank Mitchner

description of formations encountered	from to	
	feet	feet
<u>Topsoil Clay</u>		<u>14</u>
<u>Fine Sand + Clay</u>	<u>14</u>	<u>27</u>
<u>Fine Sand</u>	<u>27</u>	<u>40</u>
<u>Sand + Gravel</u>	<u>40</u>	<u>144</u>

Summer Miss

(mailing address)

WELL LOCATION:

sec 22 T. 25 N R 1 E
 W
1 miles East of Pragil
 (distance) (direction) (nearest town)


WELL PURPOSE: IRRIGATION
 (home, irrigation, municipal, industrial)

WELL COMPLETION DATA:

- diameter (inches) 6"
- total depth (feet) 137.6
- static water level (feet) 11 below above top of ground.
- casing 6" 89.6
 (material) (depth)
- 6" if telescope see back.
 (size)
- screen 48 89.6
 (length) (depth to top)
- 6" Daerr
 (size) (material)
- pump 30 1000 up
 (HP) (yield gpm)
- Tractor
 (type power)
- electric log NO
 (yes or no)
- (organization running log)
- how well bottom plugged Welded


CODED

DRILLERS REMARKS:

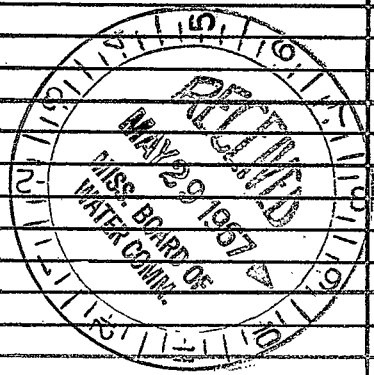

If well telescopes please sketch and show depths.

GROUND LEVEL

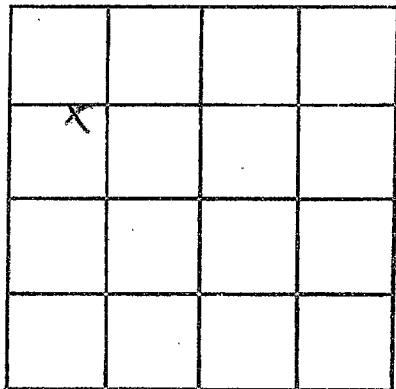

SECTION 23

Please indicate well location X.

ADDITIONAL INFORMATION

If more than one screen,
show locations of each on sketch.