

TALLAHATCHIE
 D 15
 3-24-75

MISSISSIPPI
 BOARD OF WATER COMMISSIONERS
 416 North State Street
 Jackson, Mississippi 39201

WATER WELL DRILLERS LOG

CODED

3/24/75 19 FIVE COUNTY FARMERS ASSN. TALLAHATCHIE
 date well completed firm name county well located

LANDOWNER: FRANK MELTON
 RT. 3
 TUTWILER, MISS.
 (mailing address)

description of formations encountered	from	to
CLAY TOPSOIL	0	32
SAND	32	44
SAND & GRAVEL	44	110

WELL LOCATION:
 sec. 14 T 25 N R 1 E
 S W
 1 miles E of BRAZIL
 (distance) (direction) (nearest town)

CODED

WELL PURPOSE: IRRIGATION
 (home, irrigation, municipal, industrial)

- WELL COMPLETION DATA:
- (1) diameter (inches) 16"
 - (2) total depth (feet) 110
 - (3) static water level (feet) 18 below top of ground.
 - (4) casing BLACK PIPE 62' (material) (depth)
 16" (size) if telescope see back.
 - (5) screen 48' 62' (length) (depth to top)
 16" BLACK LOUVRE (size) (material)
 - (6) pump 80 3000 (HP) (yield gpm)
 DIESEL (type power)
 - (7) electric log No (yes or no)
 (organization running log)
 - (8) how well bottom plugged WELDED


RECEIVED
 MAR 27 1975

DRILLERS REMARKS:

MISS. BD. OF WATER COMM

If well telescopes please sketch and show depths.

GROUND LEVEL

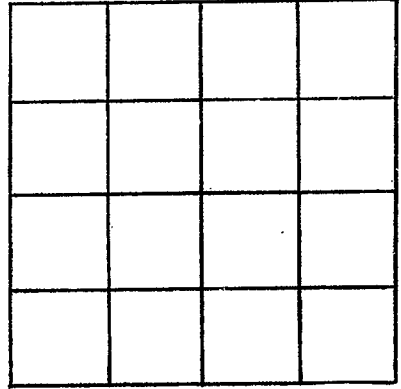

SECTION _____

Please indicate well location X.

ADDITIONAL INFORMATION

If more than one screen, show locations of each on sketch.