

Tallahatchie
D16
3-29-75

MISSISSIPPI
BOARD OF WATER COMMISSIONERS
416 North State Street
Jackson, Mississippi 39201

CODED

WATER WELL DRILLERS LOG

3/29/75
date well completed

19 FIVE COUNTY FARMERS ASSN.
firm name

Tallahatchie
county well located

LANDOWNER: FRANK MELTON
Rt. 3
TUTWILER, Miss.
(mailing address)

description of formations encountered	from	to
CLAY TOPSOIL	0	16
SAND	16	36
SAND & LARGE GRAVEL	36	118

WELL LOCATION:
sec. 9 T. 25N R. 1 E
2 miles W of STOVER
(distance) (direction) (nearest town)

WELL PURPOSE: IRRIGATION
(home, irrigation, municipal, industrial)

- WELL COMPLETION DATA:
- (1) diameter (inches) 16"
 - (2) total depth (feet) 118'
 - (3) static water level (feet) 4' below top of ground.
 - (4) casing BLACK PIPE 70' (material) (depth)
16" (size) if telescope see back.
 - (5) screen 48' 70' (length) (depth to top)
16" BLACK LOUVER (size) (material)
 - (6) pump 80 3000 (HP) (yield gpm)
DIESEL POWER UNIT (type power)
 - (7) electric log No. (yes or no)
 - (8) how well bottom plugged WELDED

CODED


RECEIVED
APR - 2 1975

MISS. BD. OF WATER COMMISSIONERS

DRILLERS REMARKS:

If well telescopes please sketch and show depths.

GROUND LEVEL

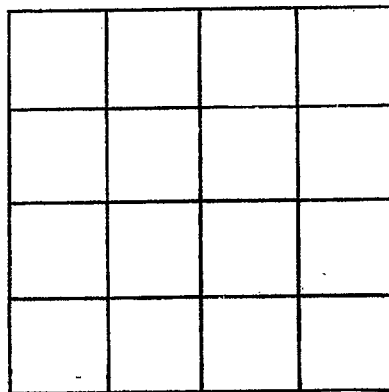

SECTION _____

Please indicate well location X.

ADDITIONAL INFORMATION

If more than one screen, show locations of each on sketch.