

Tallahatchie
D 17
6-12-75

MISSISSIPPI
BOARD OF WATER COMMISSIONERS CODED
416 North State Street
Jackson, Mississippi 39201

WATER WELL DRILLERS LOG

BUTANE GAS CO. OF GREENWOOD

6-12-75
date well completed.

19

firm name

Tallahatchie
county well located

LANDOWNER:	description of formations encountered	from	to
PAUL PENNINGTON			
SUMNER (mailing address)	Sand	20	40
WELL LOCATION:	Clay	40	50
sec. <u>27</u> T <u>25</u> N R <u>1</u> E 15F S W	SAND & GRAVEL	50	103
<u>4</u> miles <u>NE</u> of <u>BRAZIL</u> (distance) (direction) (nearest town)			
WELL PURPOSE: <u>FRR</u> (home, irrigation, municipal, industrial)			
WELL COMPLETION DATA:			
(1) diameter (inches) <u>16"</u>			
(2) total depth (feet) <u>103</u>			
(3) static water level (feet) <u>16</u> below top of ground. above			
(4) casing <u>Steel</u> , <u>63</u> , (material) (depth)			
<u>16"</u> if telescope see back. (size)			
(5) screen <u>40</u> , <u>63</u> (length) (depth to top)			
<u>16"</u> , <u>Steel</u> (size) (material)			
(6) pump <u>60</u> <u>3000</u> (HP) (yield gpm)			
<u>Diesel</u> (type power)			
(7) electric log <u>NO</u> (yes or no)			
(organization running log)			
(8) how well bottom plugged <u>Steel plate</u>			
DRILLERS REMARKS:			


CODED

MISSISSIPPI
JUN 16 1975

MISS. BD. OF WATER COMMISSIONERS

If well telescopes please sketch and show depths.

GROUND LEVEL

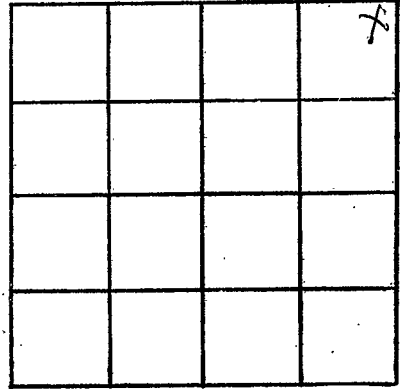

SECTION _____

Please indicate well location X.

ADDITIONAL INFORMATION

If more than one screen,
show locations of each on sketch.