

Tallahatchie  
 D 18  
 6-17-75

MISSISSIPPI  
 BOARD OF WATER COMMISSIONERS  
 416 North State Street  
 Jackson, Mississippi 39201

CODED

WATER WELL DRILLERS LOG

6-17-75 19 BUTANE GAS CO. OF GREENWOOD Tallahatchie  
 date well completed firm name county well located

LANDOWNER:	description of formations encountered	from	to
PAUL PENNINGTON			
SUMNER, MISS. (mailing address)	SAND	10	20
WELL LOCATION:	SAND + PEAS GRAVEL	20	60
sec. 31 T 25 N R 1 E 15th	SAND + GRAVEL	60	96
1 1/2 miles NE of Sumner (distance) (direction) (nearest town)			
WELL PURPOSE: IRR (home, irrigation, municipal, industrial)			
WELL COMPLETION DATA:			
(1) diameter (inches) 6			
(2) total depth (feet) 96			
(3) static water level (feet) 16 below top of ground.			
(4) casing Steel 56 (material) (depth)			
6 (size) if telescope see back.			
(5) screen 40 56 (length) (depth to top)			
6" Steel (size) (material)			
(6) pump 30 1000 (HP) (yield gpm)			
Diesel (type power)			
(7) electric log No (yes or no)			
(organization running log)			
(8) how well bottom plugged Steel Plate			
DRILLERS REMARKS:			


CODED

RECEIVED  
 JUN 19 1975

MISS. BD. OF WATER COMMISSIONERS

If well telescopes please sketch and show depths.

GROUND LEVEL

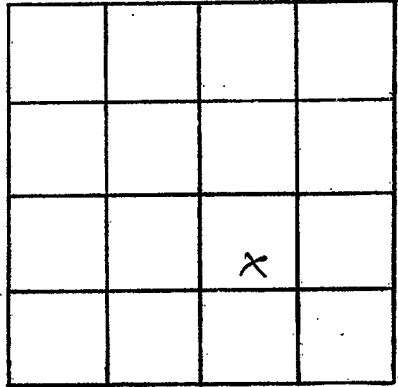

SECTION 31

Please indicate well location X.

ADDITIONAL INFORMATION

If more than one screen,  
show locations of each on sketch.