

Tallahatchie
D 19
2-19-75

MISSISSIPPI
BOARD OF WATER COMMISSIONERS
416 North State Street
Jackson, Mississippi 39201

CODED

WATER WELL DRILLERS LOG

July 19, 1975 Hoparka Plantation Tallahatchie
date well completed firm name county well located

LANDOWNER: Hoparka Plantation Sumner, Miss. (mailing address)	description of formations encountered	from	to
	Clay	0	30'
	Coarse gravel	30	75'
	Coarse sand & gravel	72	102'
WELL LOCATION:			
sec. 26 T 25 N R 1 E 1 miles South of Brazil (distance) (direction) (nearest town)			
WELL PURPOSE: irrigation (home, irrigation, municipal, industrial)			
WELL COMPLETION DATA:			
(1) diameter (inches) 10"			
(2) total depth (feet) 102'			
(3) static water level (feet) _____ below top of ground. above			
(4) casing Steel 62' (material) (depth) 10" if telescope see back. (size)			
(5) screen 40' 62' (length) (depth to top) 10" Steel (size) (material)			
(6) pump 20 900 (HP) (yield gpm) tractor (type power)			
(7) electric log no (yes or no) (organization running log)			
(8) how well bottom plugged steel plate			
DRILLERS REMARKS:			


CODED

RECEIVED
JUL 20 1975

JUL 8 1975

If well telescopes please sketch and show depths.

GROUND LEVEL

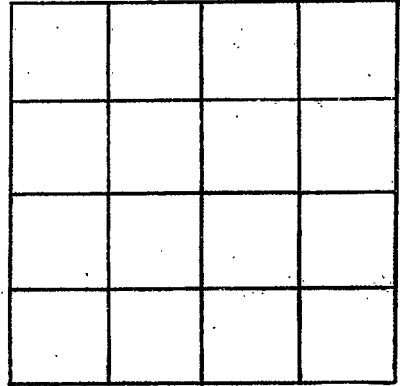

SECTION _____

Please indicate well location X.

ADDITIONAL INFORMATION

If more than one screen, show locations of each on sketch.