

Gallahatchie
D 20
7-22-75

MISSISSIPPI
 BOARD OF WATER COMMISSIONERS
 416 North State Street
 Jackson, Mississippi 39201

WATER WELL DRILLERS LOG

CODED

July 22, 1975 date well completed
 Hoparka Plantation firm name
 Gallahatchie county well located

LANDOWNER:	description of formations encountered	from	to
Hoparka Plantation			
Sumner, Miss.	Coarse sand	25	40'
(mailing address)	Coarse sand & gravel	40	90'
WELL LOCATION:	Coarse sand	90	102'
sec 21 T 25 N R 1 E 15f			
1 1/2 miles West of Brazil			
(distance) (direction) (nearest town)			
WELL PURPOSE: irrigation			
(home, irrigation, municipal, industrial)			
WELL COMPLETION DATA:			
(1) diameter (inches) 16"			
(2) total depth (feet) 102'			
(3) static water level (feet) 8' 8" below top of ground.			
(4) casing Steel 72' (material) (depth)			
16" (size) If telescope see back.			
(5) screen 40' 72' (length) (depth to top)			
16" (size) Steel (material)			
(6) pump 40 2,000 (HP) (yield gpm)			
tractor (type power)			
(7) electric log no (yes or no)			
(organization running log)			
(8) how well bottom plugged steel plate			
DRILLERS REMARKS:			


CODED

RECORDED
 INDEXED
 JUL 28 1975

MISSISSIPPI BOARD OF WATER COMMISSIONERS

If well telescopes please sketch and show depths.

GROUND LEVEL

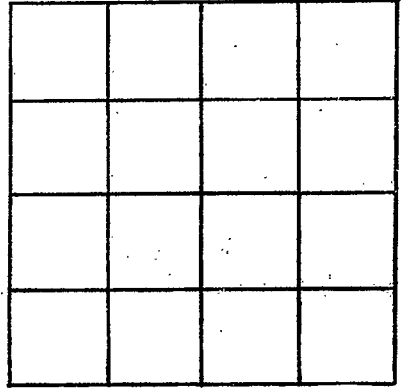

SECTION _____

Please indicate well location X.

ADDITIONAL INFORMATION

If more than one screen, show locations of each on sketch.