

TALLAHATCHIE
 D 24
 6-21-78

MISSISSIPPI
 BOARD OF WATER COMMISSIONERS
 416 North State Street
 Jackson, Mississippi 39201

CODED

WATER WELL DRILLERS LOG

6-21-1978 date well completed
 78 Fine Co. Forman, Miss firm name
 Tallahatchie county well located

LANDOWNER: Frank Melton
 P.O. 2, Zutterville, Miss.
 (mailing address)

description of formations encountered	from	to
entry clay	0	12
fine sand	12	30
coarse sand	30	50
sand & gravel	50	105

WELL LOCATION:
 sec. 18 T. 25 N. R. 1 E.
 S W
 3 miles east of Brazil
 (distance) (direction) (nearest town)

CODED

WELL PURPOSE: domestic
 (home, irrigation, municipal, industrial)

- WELL COMPLETION DATA:
- (1) diameter (inches) 12
 - (2) total depth (feet) 105
 - (3) static water level (feet) 10 below top of ground.
 - (4) casing PVC, 65 (material), (depth)
 12 (size) if telescope see back.
 - (5) screen 40 (length), 72 (depth to top)
 12" (size), PVC (material)
 - (6) pump 40 (HP), 1800 (yield gpm)
 diesel (type power)
 - (7) electric log NO (yes or no)
 (organization running log)
 - (8) how well bottom plugged Cop


RECEIVED

AUG 18 1978

DRILLERS REMARKS:

If well telescopes please sketch and show depths.

GROUND LEVEL

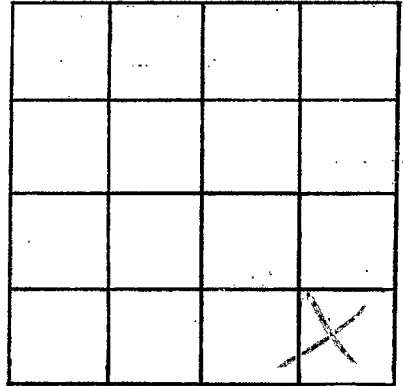

SECTION 25

Please indicate well location X.

ADDITIONAL INFORMATION

If more than one screen, show locations of each on sketch.