

TALLAHATCHIE  
D 25  
3-20-79

MISSISSIPPI  
BOARD OF WATER COMMISSIONERS  
416 North State Street  
Jackson, Mississippi 39201

CODED

WATER WELL DRILLERS LOG

3-20 date well completed 1979 Five Co. Farmers firm name Tallahatchie county well located

LANDOWNER: Frank Mitchem  
webb miss  
(mailing address)

description of formations encountered	from	to
top clay	0	9
fine sand	9	36
Coarse sand	36	69
Sand & Gravel	69	100

WELL LOCATION:  
sec 28 T 35 N R 1 E  
S W  
2 miles west of Bogal  
(distance) (direction) (nearest town)

WELL PURPOSE: municipal  
(home, irrigation, municipal, industrial)

- WELL COMPLETION DATA:
- (1) diameter (inches) 4"
  - (2) total depth (feet) 100
  - (3) static water level (feet) 15 below top of ground.
  - (4) casing PVC 70 (material) (depth)  
(size) if telescope see back.
  - (5) screen 30 70 (length) (depth to top)  
4" PVC (size) (material)
  - (6) pump 2 40 (HP) (yield gpm)  
Electric (type power)
  - (7) electric log no (yes or no)  
(organization running log)
  - (8) how well bottom plugged Cap

DRILLERS REMARKS:


Miss. Board of Water Comm.

MAR 27 1979

RECEIVED

If well telescopes please sketch and show depths.

GROUND LEVEL

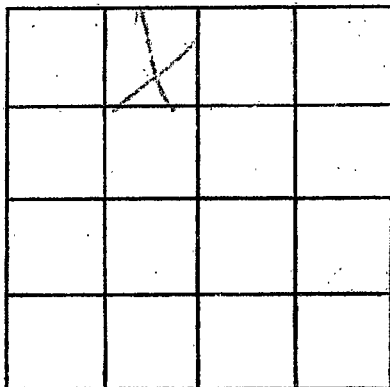

SECTION 28

Please indicate well location X.

ADDITIONAL INFORMATION

If more than one screen, show locations of each on sketch.