

LALEWATCHE  
DZY  
3/26/79

MISSISSIPPI  
 BOARD OF WATER COMMISSIONERS  
 416 North State Street  
 Jackson, Mississippi 39201

CODED

WATER WELL DRILLERS LOG

3-26 1979 Five Co. Farmers Assoc Falbertville  
 date well completed firm name county well located

LANDOWNER: JAMES A. GASTON  
211 Boyd  
CLARKSDALE Miss  
 (mailing address)

description of formations encountered	from	to
<u>Top Clay</u>	<u>0</u>	<u>12</u>
<u>Coarse sand</u>	<u>12</u>	<u>28</u>
<u>Fine sand</u>	<u>28</u>	<u>46</u>
<u>Coarse sand</u>	<u>46</u>	<u>68</u>
<u>sand &amp; Gr</u>	<u>68</u>	<u>128</u>

WELL LOCATION:  
 sec. 12 T 25 N R 1 E  
 S W  
2 miles west of STOVER  
 (distance) (direction) (nearest town)

WELL PURPOSE: irrigation  
 (home, irrigation, municipal, industrial)

- WELL COMPLETION DATA:
- (1) diameter (inches) 1 1/2"
  - (2) total depth (feet) 128'
  - (3) static water level (feet) 1.3 <sup>below</sup> <sub>above</sub> top of ground.
  - (4) casing Steel, 80  
 (material) (depth)  
 (size) if telescope see back.
  - (5) screen 48', 80'  
 (length) (depth to top)  
16", dozer  
 (size) (material)
  - (6) pump 60, 3400  
 (HP) (yield gpm)  
diurnal  
 (type power)
  - (7) electric log no  
 (yes or no)  
 (organization running log)
  - (8) how well bottom plugged welded

DRILLERS REMARKS:

CODED


Miss. Board of Water Comm.

APR 9 - 1979

RECEIVED

If well telescopes please sketch and show depths.

GROUND LEVEL

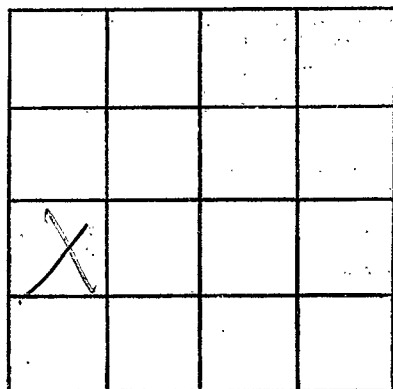

SECTION \_\_\_\_\_

Please indicate well location X.

ADDITIONAL INFORMATION

If more than one screen,  
show locations of each on sketch.