

TALLAHATCHIE
 D 38
 6-7-79

MISSISSIPPI
 BOARD OF WATER COMMISSIONERS
 416 North State Street
 Jackson, Mississippi 39201

CODED

WATER WELL DRILLERS LOG

6-7-79 date well completed 1979 Fine Co. Formerly Tallahatchie firm name Tallahatchie county well located

LANDOWNER: <u>Bill Williams</u>	description of formations encountered		from	to
<u>Frederick Min</u>	<u>top clay</u>		0	14
(mailing address)	<u>fine sand</u>		14	38
	<u>med sand</u>		38	50
	<u>coarse sand</u>		50	68
	<u>small & med</u>		68	110

WELL LOCATION:
 sec 34 T 20 N R 1 E
 S W
3 miles South of Bradley
 (distance) (direction) (nearest town)

CODED

WELL PURPOSE:
 (home, irrigation, municipal, industrial)

WELL COMPLETION DATA:

(1) diameter (inches) 16"

(2) total depth (feet) 110'

(3) static water level (feet) 13 ^{below}/_{above} top of ground.

(4) casing Std 60'
 (material) (depth)
 (size) if telescope see back.

(5) screen 50' 60'
 (length) (depth to top)
16" Std. cloes
 (size) (material)

(6) pump 60 3200
 (HP) (yield gpm)
diesel
 (type power)

(7) electric log 128
 (yes or no)
 (organization running log)

(8) how well bottom plugged Washed

Miss. Board of Water Comm.

AUG 6 1979

DRILLERS REMARKS:


RECEIVED

If well telescopes please sketch and show depths.

GROUND LEVEL

14 0
 12 14
 10 16
 8 18
 6 20
 4 22
 2 24

Handwritten notes and sketches, possibly representing well components or measurements.

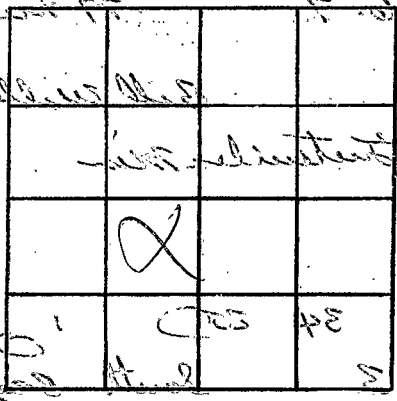

SECTION 341

Please indicate well location X.

ADDITIONAL INFORMATION

Handwritten notes in the additional information section, including '10', '12', '14', '16', '18', '20', and '22'.

If more than one screen, show locations of each on sketch.