

CODED

TALLAHATCHIE

D 39

5-27-79

MISSISSIPPI
BOARD OF WATER COMMISSIONERS
416 North State Street
Jackson, Mississippi 39201

WATER WELL DRILLERS LOG

5-27 1979 Fin Co. Formers Tallahatchie
date well completed firm name county well located

LANDOWNER: Frank Mitchell
Summer Miss

description of formations encountered	from	to
top clay	1	17
fin's sand	17	26
med sand	26	52
coar. sand	52	68
sand & gra	68	104

(mailing address)

WELL LOCATION:
sec. 3 T 25 N R 1 E
S W
3 miles North of Beauregard
(distance) (direction) (nearest town)

CODED

WELL PURPOSE:
(home, irrigation, municipal, industrial)

- WELL COMPLETION DATA:
- (1) diameter (inches) 14"
 - (2) total depth (feet) 106'
 - (3) static water level (feet) 14 ^{below} _{above} top of ground.
 - (4) casing steel 56'
(material) (depth)
 - _____ if telescope see back.
(size)
 - (5) screen 50' 56'
(length) (depth to top)
 - 14" steel doors
(size) (material)
 - (6) pump 30 1600
(HP) (yield gpm)
 - S.P. Gas
(type power)
 - (7) electric log no
(yes or no)
 - _____ (organization running log)
 - (8) how well bottom plugged welded

Miss. Board of Water Comm.


AUG 6 1979

DRILLERS REMARKS:

RECEIVED

If well telescopes please sketch and show depths.

GROUND LEVEL

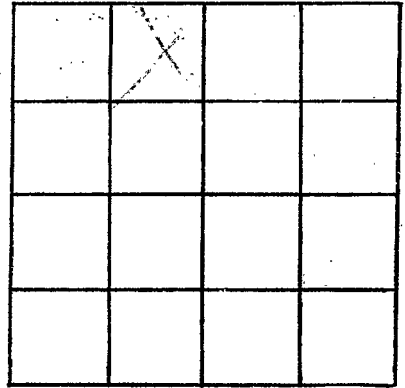

SECTION 3

Please indicate well location X.

ADDITIONAL INFORMATION

If more than one screen,
show locations of each on sketch.