

Tallahatchie

MISSISSIPPI BOARD OF WATER COMMISSIONERS
416 North State Street
Jackson, Mississippi 39201

CODED

WATER WELL DRILLERS LOG

6-9-80 1980 Five Co. Farms, Inc. Tallahatchie
date well completed firm name county well located

LANDOWNER: Frank Mitchell

description of formations encountered

from to

well man

(mailing address)

WELL LOCATION:

sec. 9 T. 25 N. R. 1 E S W

2 1/2 miles south of Bogal (distance) (direction) (nearest town)

WELL PURPOSE:

(home, irrigation, municipal, industrial)

CODED

WELL COMPLETION DATA:

- (1) diameter (inches) 12" 12
- (2) total depth (feet) 110'
- (3) static water level (feet) 13 below top of ground.

- (4) casing PVC, 70' (material) (depth) 12" (size) if telescope see back.

- (5) screen 110' 70' (length) (depth to top) 12" (size) PVC (material)

- (6) pump 30 (HP) 1800 (yield gpm) diesel (type power)

- (7) electric log C.O. (yes or no)

(organization running log)

- (8) how well bottom plugged C.O.

DEPT. OF NATURAL RESOURCES
BUREAU OF LAND & WATER RESOURCES


JUL 25 1980

DRILLERS REMARKS:

RECEIVED

If well telescopes please sketch and show depths.

GROUND LEVEL

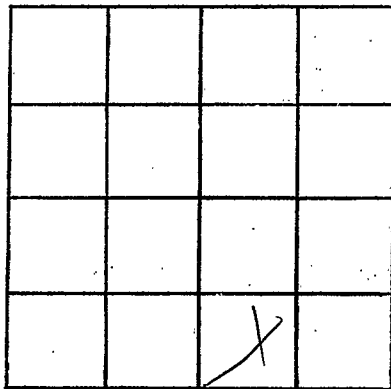

SECTION 9

Please indicate well location X.

ADDITIONAL INFORMATION

If more than one screen,
show locations of each on sketch.