

Tallahatchie

D-42

6-9-80

6-9

date well completed

1980

Fair Co. Farmers Assoc

firm name

Tallahatchie

county well located

MISSISSIPPI  
BOARD OF WATER COMMISSIONERS  
416 North State Street  
Jackson, Mississippi 39201

## WATER WELL DRILLERS LOG

CODED

LANDOWNER:

Mitchner, Frank

Webb, Min

description of formations  
encountered

from

to

(mailing address)

WELL LOCATION:

sec. 9 T. 25 N. R. 1 E. S. 5 W.  
3 miles north of Bogal  
(distance) (direction) (nearest town)

WELL PURPOSE:

(home, irrigation, municipal, industrial)

WELL COMPLETION DATA:

- (1) diameter (inches) 12"  
(2) total depth (feet) 115'  
(3) static water level (feet) 13 below top of ground.  
(4) casing PVC, 85 (material) (depth)  
12" (size) If telescope see back.  
(5) screen 40' 85' (length) (depth to top)  
12" PVC (size) (material)  
(6) pump 30 1800 (HP) (yield gpm)  
direct (type power)  
(7) electric log yes (yes or no)

(organization running log)

(8) how well bottom plugged yes

DRILLERS REMARKS:


DEPT. OF NATURAL RESOURCES  
BUREAU OF LAND & WATER RESOURCES

JUL 25 1980

RECEIVED

If well telescopes please  
sketch and show depths.

GROUND LEVEL

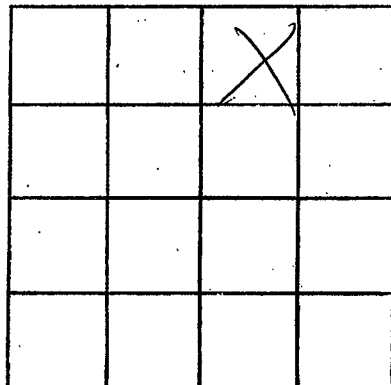

SECTION 9

Please indicate well location X.

ADDITIONAL INFORMATION

If more than one screen,  
show locations of each on sketch.