

43
ALLA HATCHIE
6-19-80

MISSISSIPPI
BOARD OF WATER COMMISSIONERS
416 North State Street
Jackson, Mississippi 39201

CODED

WATER WELL DRILLERS LOG

Tolohatchie

June 19 1980 Delta Well Supply Bolivar
date well completed firm name county well located

| LANDOWNER: | description of formations encountered | from | to |
|--|---------------------------------------|------|-----|
| Bill Allison | top soil | 0 | 13 |
| Trulwily, Miss | fine sand | 13 | 25 |
| (mailing address) | coarse sand | 25 | 60 |
| | coarse sand & gravel | 60 | 109 |
| | Bottom | | 109 |
| WELL LOCATION: | | | |
| sec. 11 T 35 N R 1 E | | | |
| 5 mi. miles South of Lumbert | | | |
| (distance) (direction) (nearest town) | | | |
| WELL PURPOSE: Irrigation | | | |
| (home, irrigation, municipal, industrial) | | | |
| WELL COMPLETION DATA: | | | |
| (1) diameter (inches) 16" | | | |
| (2) total depth (feet) 109 | | | |
| (3) static water level (feet) 9 below top of ground. | | | |
| (4) casing steel (material) (depth) | | | |
| (size) If telescope see back. | | | |
| (5) screen 40' (length) (depth to top) | | | |
| 16" steel (size) (material) | | | |
| (6) pump 30 1800 (HP) (yield gpm) | | | |
| Diesel (type power) | | | |
| (7) electric log no (yes or no) | | | |
| (organization running log) | | | |
| (8) how well bottom plugged Steel Plate | | | |
| DRILLERS REMARKS: | | | |

CODED

DEPT. OF NATURAL RESOURCES
BUREAU OF LAND & WATER RESOURCES

SEP 8 - 1980
RECEIVED

If well telescopes please
sketch and show depths.

GROUND LEVEL

9'

Water Level =


16"

Casing

16" X 40'

Screen

If more than one screen,
show locations of each on sketch.

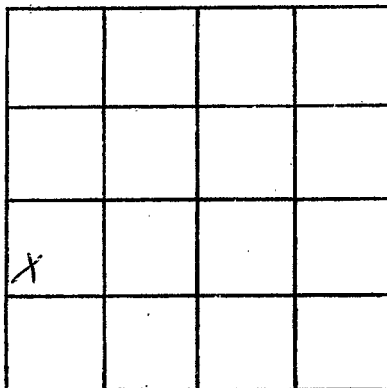

SECTION 11

Please indicate well location X.

ADDITIONAL INFORMATION