

BOARD OF WATER COMMISSIONERS

416 North State Street

Jackson, Mississippi 39201

WATER WELL DRILLERS LOG

Tallahatchie
D49

Tallahatchie
county well located

19 81
date well completed

Dye
firm name

LANDOWNER:

BIG D

DELTA HAVEN

Brook (mailing address)

WELL LOCATION:

sec 24 T 25 N R 1 E
3 miles E of Brook
(distance) (direction) (nearest town)

WELL PURPOSE: Irrigation
(home, irrigation, municipal, industrial)

WELL COMPLETION DATA:

(1) diameter (inches) 16"

(2) total depth (feet) 113'

(3) static water level (feet) 22' below above top of ground.

(4) casing Steel 113'
(material) (depth)

16" if telescope see back.
(size)

(5) screen 40' 73'
(length) (depth to top)

16" Steel
(size) (material)

(6) pump 80 1200
(HP) (yield gpm)

Diesel
(type power)

(7) electric log _____
(yes or no)

(organization running log)

(8) how well bottom plugged plate

DRILLERS REMARKS:

Description of formations encountered


CODED

from to

<u>Clay</u>	<u>0</u>	<u>20</u>
<u>Med Sand</u>	<u>20</u>	<u>30</u>
<u>Sand</u>	<u>30</u>	<u>55</u>
<u>Sand & Gravel</u>	<u>55</u>	<u>113</u>

CODED



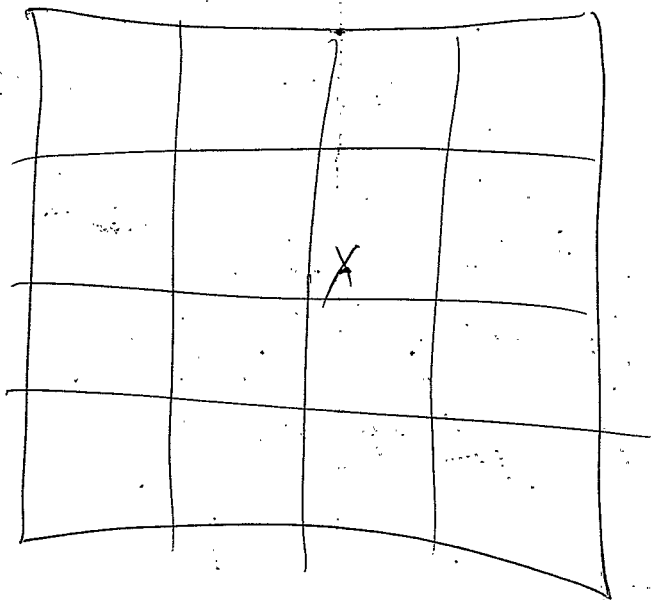

Sle 24