

Jalalatchie
D 50
3-27-81

MISSISSIPPI
 BOARD OF WATER COMMISSIONERS
 416 North State Street
 Jackson, Mississippi 39201

CODED

WATER WELL DRILLERS LOG

3-27 1981 Five Co Formers Jalalatchie
 date well completed firm name county well located

LANDOWNER Paul Fortner
Webb Mein

description of formations encountered	from	to
<u>Top clay</u>	<u>0</u>	<u>71</u>
<u>Red sand</u>	<u>71</u>	<u>20</u>
<u>Thin sand</u>	<u>20</u>	<u>36</u>
<u>Coar sand</u>	<u>36</u>	<u>74</u>
<u>Red clay</u>	<u>74</u>	<u>110</u>

(mailing address)

WELL LOCATION:

sec 2 T 25 N R 1 S
2 miles N of STOVER
 (distance) (direction) (nearest town)

WELL PURPOSE:

(home, irrigation, municipal, industrial)

WELL COMPLETION DATA:

- (1) diameter (inches) 12"
- (2) total depth (feet) 110
- (3) static water level (feet) 14 below top of ground. above
- (4) casing Steel, 60'
 (material) (depth)
12" if telescope see back.
 (size)
- (5) screen 50', 60'
 (length) (depth to top)
12", Steel-Brown
 (size) (material)
- (6) pump 40, 1800
 (HP) (yield gpm)
Direct
 (type power)
- (7) electric log _____
 (yes or no)

(organization running log)

(8) how well bottom plugged sealed

DRILLERS REMARKS:

CODED

DEPT. OF NATURAL RESOURCES
 BUREAU OF LAND & WATER RESOURCES


AUG 26 1981

RECEIVED

1 2 3 4 5 6 7 8 9 10 11 12 13 14 15 16 17 18 19 20 21 22 23 24 25 26 27 28 29 30 31
 AUG 26 1981
RECEIVED
 12345678910111213141516171819202122232425262728293031

If well telescopes please sketch and show depths.

GROUND LEVEL

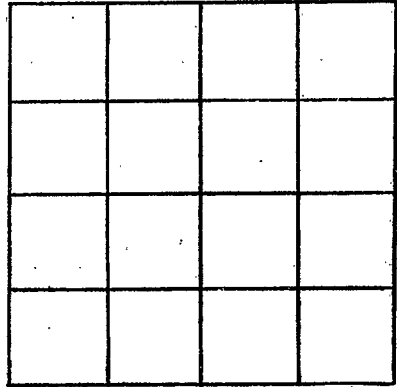

SECTION _____

Please indicate well location X.

ADDITIONAL INFORMATION

If more than one screen, show locations of each on sketch.