

CODED

Zallabatchie
D 51
3-25-81

MISSISSIPPI
BOARD OF WATER COMMISSIONERS
416 North State Street
Jackson, Mississippi 39201

WATER WELL DRILLERS LOG


3-25 1981 Zinc Co. Form. Area Zallabatchie
date well completed firm name county well located

LANDOWNER: <u>Frank Walter</u>	description of formations encountered	from	to
<u>Brazil Min.</u> (mailing address)	<u>Top clay</u>	<u>0</u>	<u>7</u>
	<u>Fine sand</u>	<u>7</u>	<u>21</u>
	<u>Med sand</u>	<u>21</u>	<u>48</u>
	<u>Coarse sand</u>	<u>48</u>	<u>72</u>
	<u>Sand & gravel</u>	<u>72</u>	<u>100</u>
WELL LOCATION: sec. <u>13</u> T. <u>25</u> N. R. <u>1</u> E. <u>3</u> <u>2</u> miles <u>East</u> of <u>Brazill</u> (distance) (direction) (nearest town)	CODED		
WELL PURPOSE: (home, irrigation, municipal, industrial)			
WELL COMPLETION DATA:			
(1) diameter (inches) <u>16"</u> (2) total depth (feet) <u>100</u> (3) static water level (feet) <u>13</u> below above top of ground. (4) casing <u>Steel</u> , <u>50'</u> (material) (depth) <u>16</u> if telescope see back. (size) (5) screen <u>50'</u> , <u>50'</u> (length) (depth to top) <u>16"</u> , <u>Steel-Brown</u> (size) (material) (6) pump <u>60</u> <u>3000</u> (HP) (yield gpm) <u>direct</u> (type power) (7) electric log <u>no</u> (yes or no) _____ (organization running log) (8) how well bottom plugged <u>welded</u>			
DRILLERS REMARKS:	DEPT. OF NATURAL RESOURCES BUREAU OF LAND & WATER RESOURCES AUG 26 1981 RECEIVED		

RECEIVED
AUG 26 1981
AUG 27 28 29 30 31

If well telescopes please sketch and show depths.

GROUND LEVEL

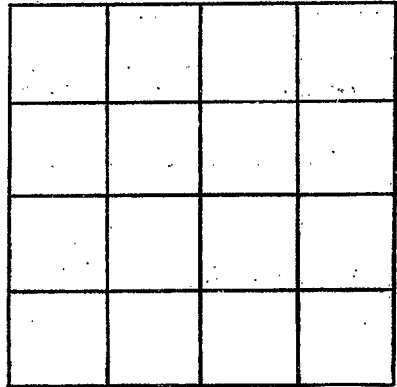

SECTION _____

Please indicate well location X.

ADDITIONAL INFORMATION

If more than one screen, show locations of each on sketch.