

MISSISSIPPI DEPARTMENT OF NATURAL RESOURCES

Bureau of Land and Water Resources

Southport Mall

P.O. Box 10631

Jackson, Mississippi 39209

WATER WELL DRILLERS LOG

CODED

TALLAHATCHIE

D 52

3/22/83

3/22/83 19
date well completed

Powell Irrigation
firm name

Tallahatchie
~~Quitman~~
county well located

LANDOWNER:	description of formations encountered	from	to
C.T. Marley Vance, MS (mailing address)	CLAY SAND + GRAVEL	1 15	15 90
WELL LOCATION:			
sec. <u>11</u> T. <u>25</u> N. R. <u>1</u> E S <u>5</u> W <u>2</u> miles <u>SW</u> of <u>Vance</u> (distance) (direction) (nearest town)			
WELL PURPOSE:			
(home, irrigation municipal, industrial)			
WELL COMPLETION DATA:			
(1) diameter (inches) <u>16</u>			
(2) total depth (feet) <u>90</u>			
(3) static water level (feet) <u>15</u> ^{below} above top of ground.			
(4) casing <u>Steel</u> , <u>50</u> , (material) (depth), <u>16</u> if telescope see back. (size)			
(5) screen <u>40</u> , <u>50</u> (length) (depth to top)			
<u>16</u> , <u>Steel</u> (size) (material)			
(6) pump <u>100</u> <u>1300</u> (HP) (yield gpm)			
<u>diesel</u> (type power)			
(7) electric log <u>NO</u> (yes or no)			
(organization running log)			
(8) how well bottom plugged <u>Steel Plate</u>			
DRILLERS REMARKS:			

CODED


DEPT. OF NATURAL RESOURCES
BUREAU OF LAND & WATER RESOURCES

MAY 20 1983

RECEIVED

If well telescopes please sketch and show depths.

GROUND LEVEL

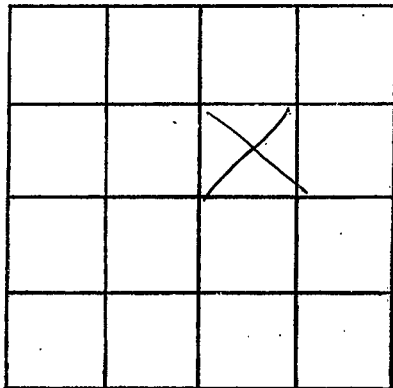

SECTION //

Please indicate well location X.

ADDITIONAL INFORMATION

If more than one screen, show locations of each on sketch.