

MISSISSIPPI DEPARTMENT OF NATURAL RESOURCES

Bureau of Land and Water Resources

Southport Mall

P.O. Box 10631

Jackson, Mississippi 39209

WATER WELL DRILLERS LOG

D53
Tallahatchie Co.
6-2-84

CODED

6/2/84 1984 Powell Irrigation Tallahatchie
date well completed firm name county well located

LANDOWNER:
Jim Wilburn
Vance, MS
(mailing address)

description of formations encountered	from	to
CLAY	0	20
Fine sand & clay	20	70
Coarse sand & gravel	70	110

WELL LOCATION:
sec. 6 T 25N R 1 E S W
1 miles East of Vance
(distance) (direction) (nearest town)

CODED

WELL PURPOSE: Irrigation
(home, irrigation, municipal, industrial)

WELL COMPLETION DATA:
(1) diameter (inches) 16"
(2) total depth (feet) 110'
(3) static water level (feet) 15' below above top of ground.
(4) casing Steel 70' (material) (depth)
if telescope see back.
(5) screen 40' 70' (length) (depth to top)
16" Steel (size) (material)
(6) pump 110 1500 (HP) (yield gpm)
diesel (type power)
(7) electric log No (yes or no)
(organization running log)

(8) how well bottom plugged
Steel Plate

DRILLERS REMARKS:


DEPT. OF NATURAL RESOURCES
BUREAU OF LAND & WATER RESOURCES

JUL 10 1984

RECEIVED

If well telescopes please sketch and show depths.

GROUND LEVEL

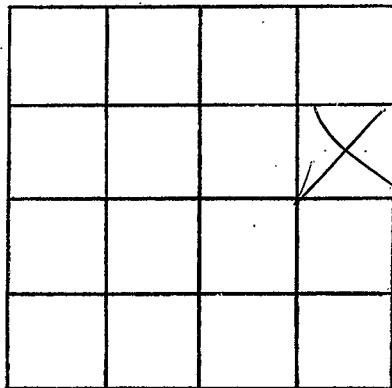

SECTION 6

Please indicate well location X.

ADDITIONAL INFORMATION

If more than one screen,
show locations of each on sketch.