

MISSISSIPPI DEPARTMENT OF NATURAL RESOURCES
Bureau of Land and Water Resources
 Southport Mall
 P.O. Box 10631
 Jackson, Mississippi 39209
WATER WELL DRILLERS LOG

CODED

D54
Tallahatchie
6-18-84

6/19/84 1984 Lowell Irrigation Tallahatchie
 date well completed firm name county well located

LANDOWNER:
Jim Wilburn
Vance, MS
 (mailing address)

description of formations encountered	from	to
<u>Clay</u>	<u>0</u>	<u>23</u>
<u>Fine Sand</u>	<u>23</u>	<u>73</u>
<u>Med + Coarse Sand</u>	<u>73</u>	<u>113</u>

WELL LOCATION:
 sec. 6 T 25 (N) S R 1 E W
2 miles East of Vance
 (distance) (direction) (nearest town)

WELL PURPOSE: Irrigation
 (home, irrigation, municipal, industrial)

- WELL COMPLETION DATA:**
- (1) diameter (inches) 16"
- (2) total depth (feet) 123'
- (3) static water level (feet) 15' below above top of ground.
- (4) casing Steel 73'
 (material) (depth)
- _____ if telescope see back.
 (size)
- (5) screen 40' 73'
 (length) (depth to top)
- 16" Steel
 (size) (material)
- (6) pump 110 1500
 (HP) (yield gpm)
- diesel
 (type power)
- (7) electric log NO
 (yes or no)
- _____ (organization running log)
- (8) how well bottom plugged Steel Plate

CODED

DEPT. OF NATURAL RESOURCES
 BUREAU OF LAND & WATER RESOURCES


JUL 10 1984

DRILLERS REMARKS:

RECEIVED

If well telescopes please sketch and show depths.

GROUND LEVEL

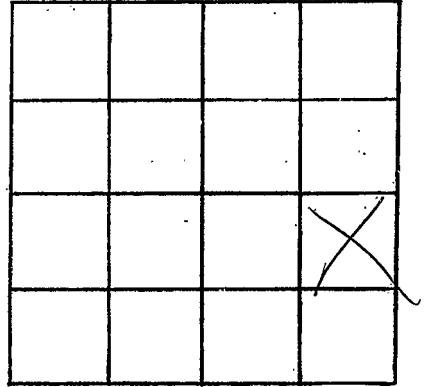

SECTION 6

Please indicate well location X.

ADDITIONAL INFORMATION

If more than one screen, show locations of each on sketch.