

MISSISSIPPI DEPARTMENT OF NATURAL RESOURCES

Bureau of Land and Water Resources

Southport Mall

P.O. Box 10631

Jackson, Mississippi 39209

WATER WELL DRILLERS LOG

BUTANE GAS COMPANY

CODED

Tallahatchie  
D55  
5/8/85

5-8  
date well completed

1985

OF GREENWOOD

Tallahatchie  
county well located

LANDOWNER:	description of formations encountered	from	to
<u>William Falke</u>	CLAY	0	25
(mailing address)	SAND	25	55
WELL LOCATION:	sand gravel	55	110
sec. <u>19</u> T <u>25</u> N R <u>1</u> E	sand clay st.	110	120
<u>4</u> miles <u>N.E.</u> of <u>Summer</u>			
WELL PURPOSE: (home, irrigation, municipal, industrial)			
WELL COMPLETION DATA:			
(1) diameter (inches) <u>4"</u>			
(2) total depth (feet) <u>120</u>			
(3) static water level (feet) <u>18</u> <u>below</u> above top of ground.			
(4) casing <u>PVC</u> , <u>70'</u> (material), (depth)			
<u>4"</u> if telescope see back. (size)			
(5) screen <u>40'</u> , <u>70</u> (length), (depth to top)			
<u>4"</u> , <u>PVC</u> (size), (material)			
(6) pump <u>3</u> , <u>100</u> (HP), (yield gpm)			
<u>Elect</u> (type power)			
(7) electric log <u>No</u> (yes or no)			
<u>No</u> (organization running log)			
(8) how well bottom plugged <u>Bank sand. Volume</u>			
DRILLERS REMARKS:			
<u>Richard West Jr.</u>			

CODED


RECEIVED

JUN 4 1985

Department of Natural Resources  
Bureau of Land & Water Resources

If well telescopes please sketch and show depths.

GROUND LEVEL

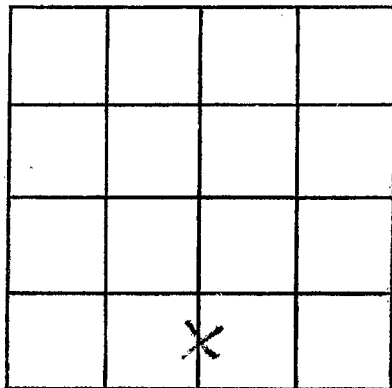

SECTION 19

Please indicate well location X.

ADDITIONAL INFORMATION

If more than one screen,  
show locations of each on sketch.