

MISSISSIPPI DEPARTMENT OF NATURAL RESOURCES

Bureau of Land and Water Resources

Southport Mall

P.O. Box 10631

Jackson, Mississippi 39209

WATER WELL DRILLERS LOG

Tallahatchie
D 56
8/26
7/8/86
 date well completed

CODED

Powell Spr firm name
Tallahatchie county well located

LANDOWNER:
Frank Mitchner
Summer 805
 (mailing address)

| description of formations encountered | from | to |
|---------------------------------------|-----------|------------|
| <u>Clay</u> | <u>0</u> | <u>13</u> |
| <u>Fine brown sand</u> | <u>13</u> | <u>33</u> |
| <u>Coarse sand & gravel</u> | <u>33</u> | <u>105</u> |

WELL LOCATION:
 sec. 10 T 25 N R 1 E
4 miles NE of Summer
 (distance) (direction) (nearest town)

WELL PURPOSE: DM
 (home, irrigation, municipal, industrial)

WELL COMPLETION DATA:

(1) diameter (inches) 12

(2) total depth (feet) 105

(3) static water level (feet) 14 below above top of ground.

(4) casing steel 65
 (material) (depth)
 (size) if telescope see back.


(5) screen 40 65
 (length) (depth to top)
12 steel
 (size) (material)

(6) pump 40 600
 (HP) (yield gpm)
diesel
 (type power)

(7) electric log no
 (yes or no)
 (organization running log)

(8) how well bottom plugged steel plate

CODED

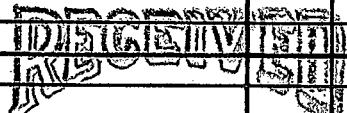


OCT 27 1986

Department of Natural Resources
 Bureau of Land & Water Resources

DRILLERS REMARKS:
86204 MGS -02

If well telescopes please sketch and show depths.

GROUND LEVEL

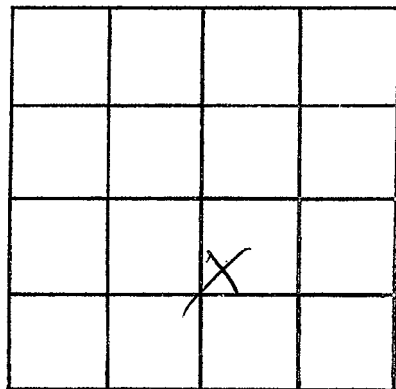

SECTION 10

Please indicate well location X.

ADDITIONAL INFORMATION

If more than one screen,
show locations of each on sketch.