

MISSISSIPPI DEPARTMENT OF NATURAL RESOURCES

Bureau of Land and Water Resources

Southport Mall

P.O. Box 10631

Jackson, Mississippi 39209

WATER WELL DRILLERS LOG

CODED

Tallahatchie
D57
8/86

7-8-86
date well completed

Powell & Co
firm name

Tallahatchie
county well located

LANDOWNER:
Mark Mitchner
Summer 005
(mailing address)

description of formations encountered	from	to
Clay	0	13
Fine sand	13	33
Coarse sand & gravel	33	105

WELL LOCATION:
sec 31 T 25 N R 1 E
4 miles N of Brazil
(distance) (direction) (nearest town)

WELL PURPOSE: Drinking
(home, irrigation, municipal, industrial)

- WELL COMPLETION DATA:
- (1) diameter (inches) 12
 - (2) total depth (feet) 105
 - (3) static water level (feet) 14 below above top of ground.
 - (4) casing Steel 65
(material) (depth)
(size) if telescope see back.
 - (5) screen 40 65
(length) (depth to top)
12 Steel
(size) (material)
 - (6) pump 40 1500
(HP) (yield gpm)
diesel
(type power)
 - (7) electric log No
(yes or no)
(organization running log)
 - (8) how well bottom plugged
Steel plate

CODED

RECEIVED
NOV 10 1986


OCT 27 1986

Department of Natural Resources
Bureau of Land & Water Resources

DRILLERS REMARKS:
86204MGS-03

If well telescopes please sketch and show depths.

GROUND LEVEL

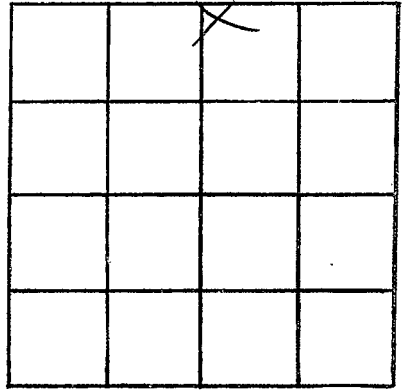

SECTION 3/

Please indicate well location X.

ADDITIONAL INFORMATION

If more than one screen,
show locations of each on sketch.