

MISSISSIPPI DEPARTMENT OF NATURAL RESOURCES

Bureau of Land and Water Resources

Southport Mall

P.O. Box 10631

Jackson, Mississippi 39209

WATER WELL DRILLERS LOG

CODED

TEP  
11750-ESD-4-9  
-89 D58

88D

4-3 1989 date well completed  
Dym Well firm name  
Tallahatchie county well located

LANDOWNER: F + G Farms  
Box 552  
Webb, Ms. 38966  
(mailing address)

description of formations encountered	from	to
CLAY	0	34
Fine Sand + Clay	34	42
Fine Sand + Gravel	42	60
M Sand + Gravel	60	84
Fine Sand + Gravel	84	90
M Sand + Gravel	90	102

WELL LOCATION:  
sec. 19 T 25 S R. 1 E W. W  
\_\_\_\_\_ miles \_\_\_\_\_ of \_\_\_\_\_  
(distance) (direction) (nearest town)

WELL PURPOSE: Irrigation  
(home, irrigation, municipal, industrial)

- WELL COMPLETION DATA:
- (1) diameter (inches) 12"
  - (2) total depth (feet) 102'
  - (3) static water level (feet) \_\_\_\_\_ below/above top of ground.
  - (4) casing steel (material), \_\_\_\_\_ (depth),  
12" (size) if telescope see back.
  - (5) screen 40' (length), \_\_\_\_\_ (depth to top),  
12" (size), \_\_\_\_\_ (material)
  - (6) pump \_\_\_\_\_ (HP), 1400 (yield gpm)  
Engine (type power)
  - (7) electric log No (yes or no)  
None (organization running log)
  - (8) how well bottom plugged Plate

CODED


RECEIVED  
APR 06 1989

Department of Natural Resources  
Bureau of Land & Water Resources  
Mississippi Department of Natural Resources  
Land & Water Resources

DRILLERS REMARKS:

If well telescopes please sketch and show depths.

GROUND LEVEL

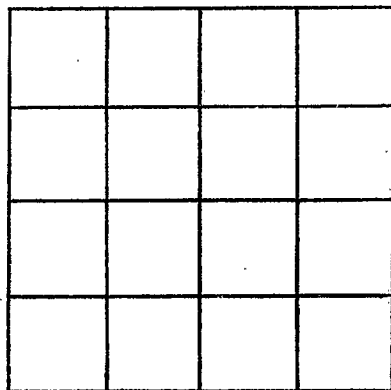

SECTION \_\_\_\_\_

Please indicate well location X.

ADDITIONAL INFORMATION

If more than one screen, show locations of each on sketch.