

MISSISSIPPI DEPARTMENT OF NATURAL RESOURCES

Bureau of Land and Water Resources

Southport Mall

P.O. Box 10631

Jackson, Mississippi 39209

WATER WELL DRILLERS LOG

Tap
11751-ESD-4-9-89
Tallahatchie
D 2000

88D

19 89 Dyn Well firm name Tallahatchie county well located
date well completed

LANDOWNER: F + G Farms
Box 552
Webb Ms. 38966
(mailing address)

description of formations encountered	from	to
Clay	0	30
Fine Sand	30	60
F Sand + Gravel	60	70
Fine Sand	70	75
F. Sand + Gravel	75	80
M. Sand + Gravel	80	105
F Sand + Gravel	105	117

WELL LOCATION:
sec. 20 T. 25 (N) R. 1 (E) S. (W)
_____ miles _____ of _____
(distance) (direction) (nearest town)

WELL PURPOSE: Irrigation
(home, irrigation, municipal, industrial)

WELL COMPLETION DATA:

(1) diameter (inches) 12"

(2) total depth (feet) 117'

(3) static water level (feet) _____ below
top of ground. above


(4) casing steel
(material) (depth) _____
12" if telescope see back.
(size)

(5) screen 40'
(length) (depth to top) _____
12"
(size) (material)

(6) pump _____
(HP) (yield gpm) _____
Engine
(type power)

(7) electric log No
(yes or no)
None
(organization running log)

(8) how well bottom plugged plate

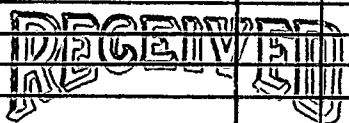


MAR 29 1989

Department of Natural Resources
Bureau of Land & Water Resources

DRILLERS REMARKS: _____

If well telescopes please
sketch and show depths.

GROUND LEVEL

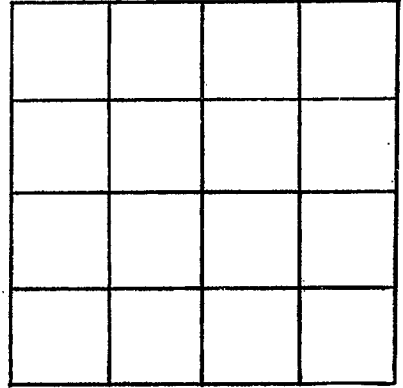

SECTION _____

Please indicate well location X.

ADDITIONAL INFORMATION

If more than one screen,
show locations of each on sketch.