

MISSISSIPPI DEPARTMENT OF NATURAL RESOURCES

Bureau of Land and Water Resources

COUNTY WELL LOCATED
 PUTMAN
 WELL NUMBER
 0
 CODED
 2001
 DATE WELL COMPLETED
 7-5-90

PERMIT NUMBER
 456W12418
 NAME OF DRILLING FIRM
 Howell & M...
 Clarksdale, Miss

P.O. Box 10631
 Jackson, Mississippi 39209
 WATER WELL DRILLERS LOG

NAME & MAILING ADDRESS OF LANDOWNER
 Jim Wilbourn
 Dixie Farms
 P.O. Box 37
 Vance, MS 38964
 WELL LOCATION: SEC 178, TOWNSHIP 25 N, RANGE 1 W
 DISTANCE 2 Miles DIRECTION E of NEAREST TOWN Vance
 OTHER LANDMARK
 WELL PURPOSE: Home, Irrigation, Municipal, Industrial, Fish Pond, etc.

PUMP DATA
 PUMP TYPE (Circle One): Submersible, Turbine, Jet, Flowing Well, Other (Describe)
 POWER TYPE (Circle One): Electric, Tractor, Diesel, Gasoline, Butane, Other (Describe) H/P
 Pump Capacity (GPM) 1500, No. of Stages 2, Setting Depth 50 FT.
 PUMP TEST
 Well yielded _____ GPM with a drawdown of _____ ft. after _____ hours of pumping

WELL DATA
 Well Depth 103, Casing Diameter (In.) 12, Casing Length (Ft.) 63
 Type of Casing Steel, Hole Depth 103, Depth to Static Water Level 17'
 TYPE OF COMPLETION: (Circle One or More): Gravel Packed, Underreamed, Telescoped, Natural Development, Open Hole, Other (Describe)
 Top of Lap Pipe or Reduction in Casing FEET IF TELESKOPED OR MORE THAN ONE SCREEN: USE BACK PAGE

LOG DATA
 TYPE OF LOG RUN (Circle One): No Log Run, Electric, Gamma Ray, Density, Sonic, Neutron, Other (Describe)
 Name of Organization Running Log

SCREEN DATA
 Diameter - Inches 12, Length - Feet 40, Slot Size - Inches .040
 Screen Type Steel, Depth to Bottom - Feet 103

GEOLOGIC DATA (Office Use Only)

Surface Elev.	Geologic Unit	Unit Thickness	Depth to Top
Subs. SWL	Date	Analysis	Aquifer Test


 Driller's Remarks

DESCRIPTION OF FORMATIONS ENCOUNTERED	FROM	TO
Top soil	0	10
fine sand	10	20
Coarse sand	20	60
Sand + gravel	60	80
Heavy gravel	80	103

FORMATIONS (Continued) FROM TO
 RECEIVED
 OCT 05 1990
 Department of Natural Resources
 Bureau of Land & Water Resources
 IF MORE SPACE IS NEEDED, USE BACK

If well telescopes please sketch and show depths.

GROUND LEVEL

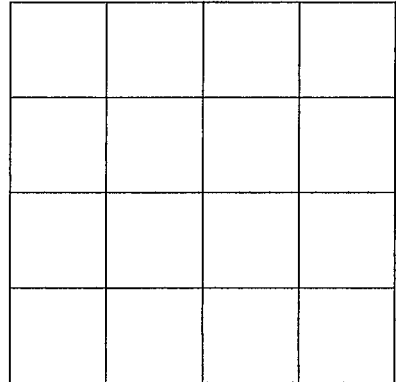

SECTION 8

Please indicate well location X.

ADDITIONAL INFORMATION

If more than one screen,
show location of each on sketch.