

MISSISSIPPI DEPARTMENT OF NATURAL RESOURCES

Bureau of Land and Water Resources

Southport Mall

P.O. Box 10631

Jackson, Mississippi 39209

WATER WELL DRILLERS LOG

CODED

TALLAHATCHIE
 F47
 5- -86

D2004

5 1986 Powell Irrigation Tallahatchie
 date well completed firm name county well located

LANDOWNER:
 Jim Wilbourn
 Clarksdale, MS
 (mailing address)

description of formations encountered	from	to
CLAY	0	13
FINE BROWN SAND	13	33
COARSE SAND AND GRAVEL	33	113

WELL LOCATION:
 sec. 18 T25N R. 2E 1W
 2 miles EAST of VANCE
 (distance) (direction) (nearest town)

CODED

WELL PURPOSE: IRR
 (home, irrigation, municipal, industrial)

WELL COMPLETION DATA:

(1) diameter (inches) 16

(2) total depth (feet) 113

(3) static water level (feet) 31 below above top of ground.


(4) casing steel 73 (material) (depth) (size) if telescope see back.

(5) screen 40 73 (length) (depth to top) 16 steel (size) (material)

(6) pump 30 1600 (HP) (yield gpm) Diesel (type power)

(7) electric log NO (yes or no) (organization running log)

(8) how well bottom plugged Steel PLATE

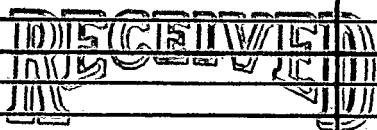


JUN 12 1986

Department of Natural Resources
 Bureau of Land & Water Resources

DRILLERS REMARKS:
 86149 MGS-07

If well telescopes please sketch and show depths.

GROUND LEVEL

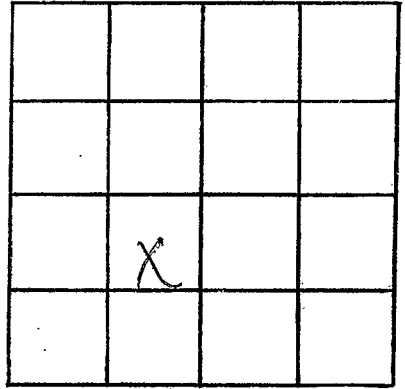

SECTION _____

Please indicate well location X.

ADDITIONAL INFORMATION

If more than one screen,
show locations of each on sketch.