

~~A~~ E-2

1-2-65

WATER WELL DRILLERS LOG

TALLA

CODED

CODED

Date: 2, 1965, Driller: J B Cain County: 1289
(Name)

(1) Owner of Land:	Description & Color of Materials Sand, Clay, Red Clay, Shell, etc.	Thick- ness Feet	Depth Feet
<u>Noland Jentry</u> (Name) <u>Crowder miss</u> (Address)	<u>Sand</u> <u>Blue Cl</u> <u>land</u>	<u>0</u>	<u>208</u>
(2) Location: <u>1/4</u> , <u>1/4</u> , Sec. <u>2</u> T <u>25</u> R <u>1E</u> <u>8</u> miles <u>S</u> of <u>Crowder</u> (distance) (direction) (Nearest Town)			<u>208390</u> <u>390450</u>
(3) Topography: <input checked="" type="checkbox"/> (Hilly) <input type="checkbox"/> (Flat) <input type="checkbox"/> (Level)			
(4) Purpose of Well: <u>Home</u> (Domestic Irrigation Municipal, Industrial, Other)			


Information upon completion of well:

- (1) Diameter 2 inches.
- (2) Total Depth 450 feet.
- (3) Water Level Flow feet below top of ground.
- (4) Cased to 400, Size 2.
- (5) Screen: Size None, Length _____.
- (6) Were any formations sealed against pollution?
_____ yes, _____ no.

If YES depth of formation _____
Why _____

Drillers Remarks: _____

CODED

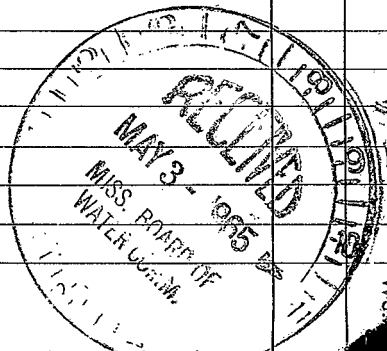

(Use Back Side)

1000

1000

