

TALAHATCHIE
 E 4
 S-3-77

MISSISSIPPI
 BOARD OF WATER COMMISSIONERS CODED
 416 North State Street
 Jackson, Mississippi 39201

WATER WELL DRILLERS LOG

May 3 1977 Delta Well & Drilling Talahatchie
 date well completed firm name county well located

LANDOWNER:	description of formations encountered	from	to
Bill Williams			
Tulsailes Nias	2 in sand	16	42
(mailing address)	Clay	42	48
	Coarse sand	48	56
	Coarse sand & gravel	56	105
	Bottom on Rock		
	Set at		105

WELL LOCATION:
 sec. 20 T. 25 N. R. 1 E
 3 miles East of Brazil
 (distance) (direction) (nearest town)

WELL PURPOSE: Irrigation
 (home, irrigation, municipal, industrial)

- WELL COMPLETION DATA:
- (1) diameter (inches) 16"
 - (2) total depth (feet) 105
 - (3) static water level (feet) 18 below top of ground.
 - (4) casing 16" (material) Steel (depth) 5 1/2'
 - (size) if telescope see back.
 - (5) screen 40' (length) Down (depth to top) 16" (size) Down (material)
 - (6) pump 60 (HP) 2600 (yield gpm)
 Diesel (type power)
 - (7) electric log no (yes or no)
 - (organization running log)
 - (8) how well bottom plugged Steep plate

DRILLERS REMARKS:


RECEIVED
 JUN 24 1977
 MISS. BD. OF WATER COMMISSIONERS

If well telescopes please sketch and show depths.

GROUND LEVEL

16"

16" x 40' screen

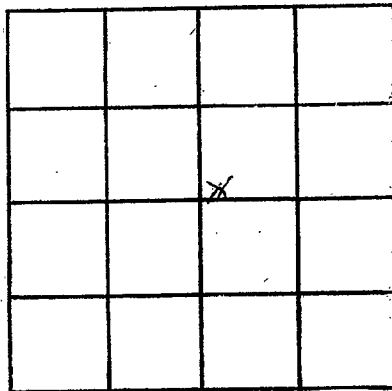

SECTION 20

Please indicate well location X.

ADDITIONAL INFORMATION

If more than one screen, show locations of each on sketch.