

TALLAHATCHIE

E5

3-13-79

MISSISSIPPI BOARD OF WATER COMMISSIONERS
416 North State Street
Jackson, Mississippi 39201

CODED

WATER WELL DRILLERS LOG

3-13

date well completed

1979 Five County Farms

firm name

Tallahatchie

county well located

LANDOWNER: Dillard Melton

Webb Min

(mailing address)

WELL LOCATION:

sec. 17 T. 25 N. R. 1 E. S. W.

3 miles East of Bogal (distance) (direction) (nearest town)

WELL PURPOSE: irrigation (home, irrigation, municipal, industrial)

WELL COMPLETION DATA:

- (1) diameter (inches) 14"
- (2) total depth (feet) 108
- (3) static water level (feet) 14 below top of ground.
- (4) casing Steel, 70 (material) (depth) if telescope see back. (size)
- (5) screen 48', 70 (length) (depth to top) 14" Steel-plate (size) (material)
- (6) pump 260, 2300 (HP) (yield gpm) Diesel (type power)
- (7) electric log (yes or no) (organization running log)
- (8) how well bottom plugged welded

description of formations encountered

from to

top clay	0	10
med sand	10	42
Coar sand	42	68
sand & gravel	68	108

CODED

Miss. Board of Water Comm.


MAR 27 1979

DRILLERS REMARKS:

RECEIVED

If well telescopes please sketch and show depths.

GROUND LEVEL

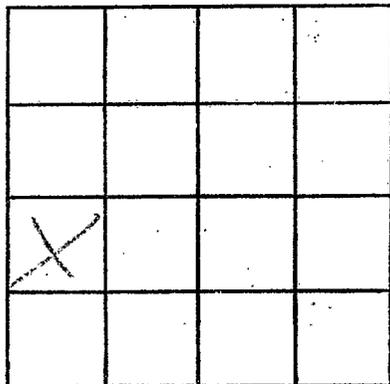

SECTION 17

Please indicate well location X.

ADDITIONAL INFORMATION

If more than one screen,
show locations of each on sketch.