

TALLAHATCHIE

E6

3-21-79

MISSISSIPPI BOARD OF WATER COMMISSIONERS 416 North State Street Jackson, Mississippi 39201

CODED

WATER WELL DRILLERS LOG

3-21

date well completed

1979 Five Co. Farms, Inc

firm name

Tallahatchie

county well located

LANDOWNER: Dillard Melton

description of formations encountered

from

to

Well min

Top clay

0

12

Red sand

12

42

Core sand

42

68

Bankt. Gr

68

117

(mailing address)

WELL LOCATION:

sec. 19 T25N R1E S W

3 miles East of Brazil

(distance) (direction) (nearest town)

CODED

WELL PURPOSE: Irrigation (home, irrigation, municipal, industrial)

WELL COMPLETION DATA:

- (1) diameter (inches) 14"
(2) total depth (feet) 117
(3) static water level (feet) 14 below top of ground.

(4) casing Steel 69' (material) (depth)

(size) if telescope see back.

(5) screen 48' 69' (length) (depth to top) 14" Steel-door (size) (material)

(6) pump 60 2300 (HP) (yield gpm)

Drill (type power)

(7) electric log (yes or no)

(organization running log)

(8) how well bottom plugged welded


Miss. Board of Water Comm.

DRILLERS REMARKS:

MAR 27 1979

If well telescopes please sketch and show depths.

GROUND LEVEL

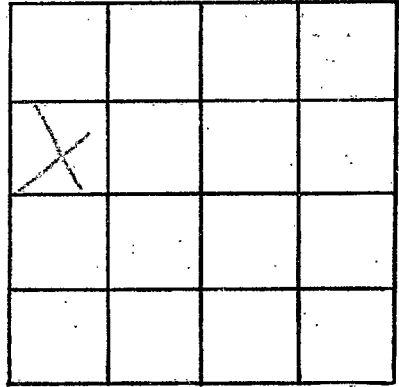

SECTION 19

Please indicate well location X.

ADDITIONAL INFORMATION

If more than one screen,
show locations of each on sketch.