

Tallahatchie

E-7

6-26-80

6-26

date well completed

MISSISSIPPI BOARD OF WATER COMMISSIONERS 416 North State Street Jackson, Mississippi 39201

WATER WELL DRILLERS LOG

CODED

19 80 Fine Co Farm, Inc

firm name

Tallahatchie county well located

LANDOWNER: J. W. Whitten

Summer Min.

(mailing address)

WELL LOCATION:

sec 18 T 25 N R 1 E

3 miles EAST of Bogal (distance) (direction) (nearest town)

WELL PURPOSE:

(home, irrigation, municipal, industrial)

WELL COMPLETION DATA:

- (1) diameter (inches) 16"
(2) total depth (feet) 110'
(3) static water level (feet) 8 below top of ground.
(4) casing Steel, 60' (material), (depth) 16" (size) if telescope see back.
(5) screen 50 (length), 60 (depth to top) 16" (size), Steel (material)
(6) pump 60 (HP), 2460 (yield gpm) Diesel (type power)
(7) electric log no (yes or no)
(8) how well bottom plugged welded

description of formations encountered

from

to

Top clay 0 7
Thin sand 7 28
Coarse sand 28 46
sand & silt 46 118

CODED

DRILLERS REMARKS:


DEPT. OF NATURAL RESOURCES BUREAU OF LAND & WATER RESOURCES

JUL 25 1980

RECEIVED

If well telescopes please sketch and show depths.

GROUND LEVEL

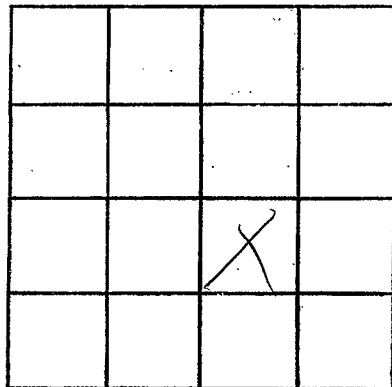

SECTION 18

Please indicate well location X.

ADDITIONAL INFORMATION

If more than one screen, show locations of each on sketch.