

TALLAHATCHIE
E 8
3-26-81

MISSISSIPPI
BOARD OF WATER COMMISSIONERS
416 North State Street
Jackson, Mississippi 39201

CODED

WATER WELL DRILLERS LOG

3-26 date well completed 1981 Fin Co. Drilling firm name Tallahatchie county well located

LANDOWNER: Frank Mellon
Brazil Min
(mailing address)
WELL LOCATION:
sect. 28 T 25 N R 1 E
S W
5 miles W of Brazil
(distance) (direction) (nearest town)

description of formations encountered	from	to
top clay	0	9
med sand	9	18
fine sand	18	36
med sand	36	52
coar sand	52	76
sand & gravel	76	100

WELL PURPOSE:
(home, irrigation, municipal, industrial)

- WELL COMPLETION DATA:
- (1) diameter (inches) 12"
 - (2) total depth (feet) 100'
 - (3) static water level (feet) 14' below top of ground.
 - (4) casing Steel, 88' (material) (depth)
12" (size) If telescope see back.
 - (5) screen 50', 50' (length) (depth to top)
12" (size) Steel-Braun (material)
 - (6) pump 40 (HP) 1800 (yield gpm)
diesel (type power)
 - (7) electric log (yes or no)
(organization running log)
 - (8) how well bottom plugged welded

DEPT. OF NATURAL RESOURCES
BUREAU OF LAND & WATER RESOURCES

AUG 26 1981


RECEIVED

RECEIVED
AUG 29 1981
22 23 24 25 26 27 28 29 30 31

DRILLERS REMARKS:

If well telescopes please sketch and show depths.

GROUND LEVEL

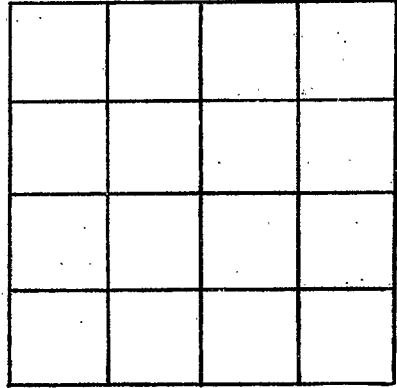

SECTION _____

Please indicate well location X.

ADDITIONAL INFORMATION

If more than one screen,
show locations of each on sketch.