Tallahatchie Part 1 Permit #: <u>MS-GW-16189</u> Mississippi Department of Environmental Quality Dirrigation Equipment Office of Land and Water Resources P.O. Box 10631 Jackson, MS 39289-0631 Date drilling completed: 10-22-04 State Law requires that this report be prepared by the driller in detail and filed with the Department within 30 days of completion of drilling of the well. Well Owner Information Well Cocation	5-
Irrigation Equipment Office of Land and Water Resources Date drilling completed: 10-22-04 State Law requires that this report be prepared by the driller in detail and filed with the Department within	5
Date drilling completed: 10-22-04 Jackson, MS 39289-0631 (601)961-5210 (601)354-6938 (fax) L. S. Elevation: E-log #: State Law requires that this report be prepared by the driller in detail and filed with the Department within 30 days of completion of drilling of the well. E-log #:)
Date drilling completed: 10-22-04 Jackson, MS 39289-0631 L. S. Elevation: Date drilling completed: (601)961-5210 E-log #: State Law requires that this report be prepared by the driller in detail and filed with the Department within 30 days of completion of drilling of the well. E-log #:	
State Law requires that this report be prepared by the driller in detail and filed with the Department within 30 days of completion of drilling of the well.	
50 days of completion of drilling of the well.	
Well Owner Information Geotechnical Construction Inc. Well Location	
Owner Name Latitude: Longitude: "	
Mailing Address: Box 239 Method of Lat/Long (circle one): Conventional Survey,	
USGS quad, Hand-held GPS, Survey-grade GPS	
Mt. Olive, IL 62069-0239 SE 1/4 NW 1/4 Sec_ 27 Twn 25N Rng 1E	
City State Zip Code	
217-999-2088 Distance Direction Nearest Town Telephone No. () Miles West of Charleston	
Well Data Corp of Engineer Project	
Purpose of Well (circle one) Home Industrial Public Supply Inigation Fish Culture Other) Dewatering	
Date well drilling started: Date well drilling completed:	
If flowing, method of flow regulation: Valve Other (describe)	
Static Water Level:feet above or below (circle one) land surface Date measured:	
Method of Measurement (circle one) steel tape electric tape air line other:	
Hole depth: 80' Well depth: 80' Well grouted to a depth of feet	
Type of grout (circle one): Coment Destauite b (in	
Casing length:feet Casing diameter:inches Type of casing:	
Screen length: <u>60</u> feet Screen diameter: <u>12</u> inches Type of screen: <u>160</u> OCT 28 20	04
Screen slot size: 40' .032 inches Setting depth: From 21 feet to 80 feet BY: OLW	'R
Type of completion (circle all applicable): Gravel packed Underreamed Telescoped Open hole Natural Development	
Other (describe):	
Top of lap pipe or reduction in casing:feet. If telescoped or more than one screen, describe on back of page	
Logs run (circle all applicable): (No log run) Electric Gamma Ray Density Sonic Neutron Other:	
Name of organization running log(s):	
I certify that the well was drilled, constructed, and completed in accordance with all applicable requirements of the Mississippi	
Department of Environmental Quality and/or the Mississinni Department of Health regulations and state laws	
Ly Irrigation Equipment Inc	
Irrigation Equipment Inc. Patrick M. Chism 0695	

.


Mailed to GCI 10-25-04

If well telescopes please sketch below and show depths.

Ground Level

Descrip	tion of Formations Encountered	From	То
Clay	•	0	20
Fine S	and/gravel	21	4 4·
Med. S	and/gravel	45	B0
			
			<u> </u>
	· ··· · · · · · · · · · · · · · · · ·		╂──
			1
			1
	······································		
•	·		<u> </u>
			_
	· · · · · · · · · · · · · · · · · · ·		-
·			<u> </u>
	· · · · · · · · · · · · · · · · · · ·		
		·	+
			+

If more than one screen, show location of each on sketch

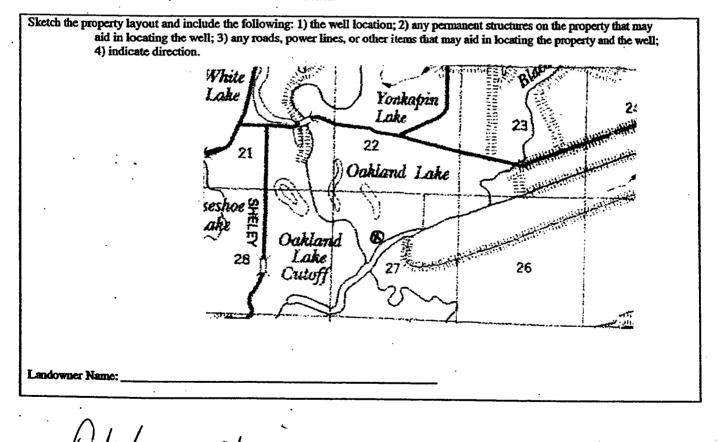

Papies M Chim

Signature of Water Well Contractor