

State Well Report

Part 1

Mississippi Department of Environmental Quality
 Office of Land and Water Resources
 P.O. Box 10631
 Jackson, MS 39289-0631
 (601)961-5210
 (601)354-6938 (fax)

County: Tallahatchie
 Permit #: EW-40805
 Irrigation Equipment
 Driller: _____
 Date drilling completed: 12-17-05

For Office Use Only:
 Aquifer: E85
 Well #: ~~F-54~~
 L. S. Elevation: _____
 E-log #: _____

State Law requires that this report be prepared by the driller in detail and filed with the Department within 30 days of completion of drilling of the well.

Well Owner Information	Well Location
Owner Name: <u>Nolan West</u>	Latitude: <u>34 00 38.8N</u> Longitude: <u>90.08 57.8W</u>
Mailing Address: <u>266 Walnut Road</u>	Method of Lat/Long (circle one): <u>Conventional Survey</u>
<u>Sardis, MS 38666</u>	USGS quad, Hand-held GPS, Survey-grade GPS
City State Zip Code	NW 1/4 NW 1/4 Sec <u>30</u> Twn <u>25N</u> Rng <u>2E</u>
Telephone No. () _____	Distance Direction Nearest Town <u>5</u> Miles <u>West</u> of <u>Charles</u>

RECEIVED
JAN 12 2006
BY: OLWR

Well Data

Purpose of Well (circle one) Home Industrial Public Supply Irrigation Fish Culture Other: _____

Date well drilling started: 12-17-05 Date well drilling completed: 12-17-05

If flowing, method of flow regulation: Valve _____ Other (describe) _____

Static Water Level: _____ feet above or below (circle one) land surface Date measured: _____

Method of Measurement (circle one) steel tape electric tape air line other: _____

Hole depth: 126' Well depth: 126' Well grouted to a depth of 10 feet

Type of grout (circle one): Cement Bentonite Mix

Casing length: 86 feet Casing diameter: 16 inches Type of casing: PVC Sch. 40

Screen length: 40 feet Screen diameter: 16 inches Type of screen: PVC Sch. 40

Screen slot size: .050 inches Setting depth: From 87 feet to 126 feet

Type of completion (circle all applicable): Gravel packed Underreamed Telescoped Open hole Natural Development

Other (describe): _____

Top of lap pipe or reduction in casing: _____ feet If telescoped or more than one screen, describe on back of page

Logs run (circle all applicable): No log run Electric Gamma Ray Density Sonic Neutron Other: _____

Name of organization running log(s): _____

I certify that the well was drilled, constructed, and completed in accordance with all applicable requirements of the Mississippi Department of Environmental Quality and/or the Mississippi Department of Health regulations and state laws.

Irrigation Equipment Inc.
 Patrick M. Chism 0695

Print Name of Water Well Contractor and License No. _____ Signature of Water Well Contractor Patrick M Chism

Owner contracted with Circle S Irrigation (Clarksdale, MS).
 Circle S Irrigation will install pump.

E85

~~F-54~~

If well telescopes please sketch below and show depths.

Ground Level


6W-40905

Description of Formations Encountered	From	To
Clay	0	21
Fine Sand	22	35
Fine Sand/gravel	36	80
Med. Sand/gravel	81	126

RECEIVED
JAN 12 2006
BY: OLWR

If more than one screen, show location of each on sketch

Sketch the property layout and include the following: 1) the well location; 2) any permanent structures on the property that may aid in locating the well; 3) any roads, power lines, or other items that may aid in locating the property and the well; 4) indicate direction.

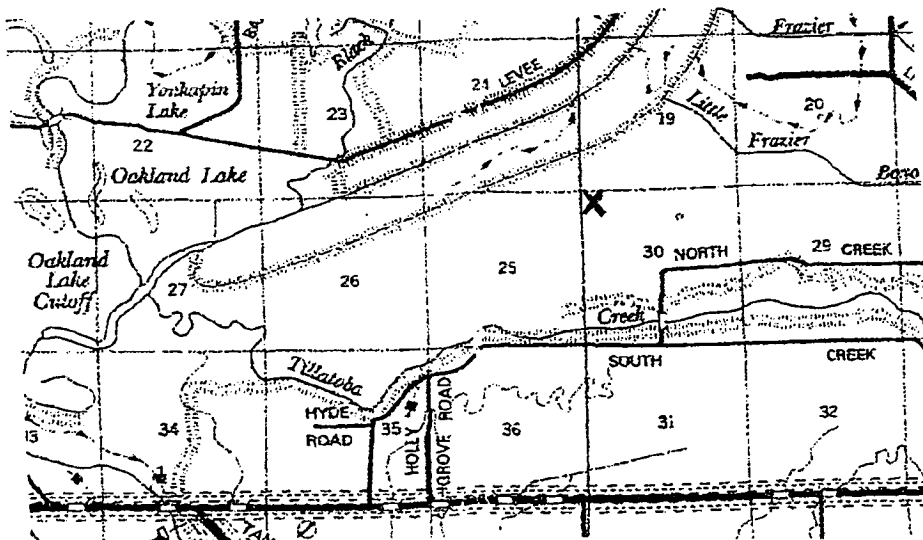

Landowner Name: _____

Patrick M. Chin
Signature of Water Well Contractor

STATE WELL REPORT

Part 2

Pump Installer's Completion Report

Mississippi Department of Environmental Quality
Office of Land and Water Resources
P.O. Box 10631
Jackson, MS 39289-0631
(601)961-5210
(601)354-6938 (fax)

County: **Tallahatchie**
Permit #: **GW-40805**
Driller: _____
Date completed: _____

For Office Use Only:
Aquifer: **E85**
Well #: ~~**F-54**~~
Elevation: _____

This report must be prepared by the pump installer in detail and filed with the Department within 30 days of the installation of pump. A copy of Part 1 of this report must be attached to this report.

Well Owner Information	Well Location
Owner Name: <u>Nolan West</u>	Latitude: <u>34° 00, 38 8N</u> Longitude: <u>90.08.57, 8W</u>
Mailing Address: <u>266 Walnut Road</u>	Method of Lat/Long (circle one): Conventional Survey, USGS quad, Hand-held GPS, Survey-grade GPS
<u>Sardis, MS 38866</u>	NW 1/4 NW 1/4 Sec 30 ^{1E} Twn <u>25N</u> Rng 2E ^{2E}
City State Zip Code	Distance Direction Nearest Town
Telephone No. <u>(662) 487-5234</u>	<u>5</u> Miles <u>West</u> of <u>Charleston</u>

RECEIVED
JAN 12 2006
BY: OLWR

Pump Type Circle one	Power Type Circle one
Air Lift Jet Submersible	<u>Diesel Engine</u> Gasoline Engine Natural Gas
Bucket Piston <u>Turbine</u>	Electric Motor Hand Tractor PTO
Centrifugal Rotary Flowing Well	Windmill Other (specify): _____
Other (specify): _____	Horse Power Rating of Motor: <u>60 H.P.</u>
Date Pump Installed: <u>12-20-05</u>	Setting Depth: <u>70</u> feet
Rated Pump Capacity: <u>3500</u> Gallons Per Minute	Number of Stages: <u>ONE</u>

Pump Test Data	Method of Measuring Water Level Circle one
Date Well Tested: _____	Air Line Electric Measuring Line Steel Tape
Static Water Level (A): _____ Feet Below Land Surface	Other (specify): _____
Pumping Water Level (B): _____ Feet Below Land Surface	For flowing well, measured shut in head: _____ feet
Drawdown [(B) - (A)]: _____ Feet Below Land Surface	Well yielded _____ GPM with a drawdown of _____ feet after _____ hours of pumping
Test Pumping Rate: _____ Gallons Per Minute	
Duration of Pump Test (minimum 4 hours): _____ hours	

I HEREBY CERTIFY that the above statements are true to the best of my knowledge.

DAVID P. HOLT 0-752 P
Print Name of Pump Installer and License No. (if applicable) [Signature]
Signature of Pump Installer