

Tallahatchie  
E 2000  
8-4-77

MISSISSIPPI  
BOARD OF WATER COMMISSIONERS  
416 North State Street  
15F Jackson, Mississippi 39201

WATER WELL DRILLERS LOG

8-4 date well completed  
1977 Life Well Co. firm name  
Tallahatchie county well located

LANDOWNER:	description of formations encountered	from	to
Annie Harris	Top soil	0	20
Charleston Ms. (mailing address)	sand	20	98
<b>WELL LOCATION:</b>			
sec. 36 T 25 N R 1 E			
3 miles west of Charleston (distance) (direction) (nearest town)			
<b>WELL PURPOSE:</b>			
(home) irrigation, municipal, industrial			
<b>WELL COMPLETION DATA:</b>			
(1) diameter (inches) 4			
(2) total depth (feet) 98			
(3) static water level (feet) 20 below top of ground.			
(4) casing PVC 88 (material) (depth)			
4 (size) if telescope see back.			
(5) screen 10 88 (length) (depth to top)			
4 PVC (size) (material)			
(6) pump 3/4 10 (HP) (yield gpm)			
elec. (type power)			
(7) electric log NO (yes or no)			
NO (organization running log)			
(8) how well bottom plugged PVC CAP			
<b>DRILLERS REMARKS:</b>			


RECEIVED

AUG 15 1977

MISS. BR. OF WATER COMMISSIONERS

If well telescopes please sketch and show depths.

GROUND LEVEL

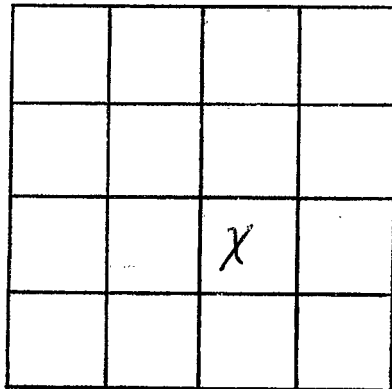

SECTION 36

Please indicate well location X.

ADDITIONAL INFORMATION

If more than one screen,  
show locations of each on sketch.