

CODED

TALLA.

WATER WELL DRILLERS LOG

Gallatalekie

F5

7-21-60

Date 7/21, 1960, Driller: James R. Lipe County Panola
 (Name)

(1) Owner of Land: Jim Worsham
 (Name)
CHARLESTON, MISS.
 (Address)

(2) Location: 1/4, 1/4, Sec. 30 R 2
1/2 miles E of Charleston
 (distance) (direction) (Nearest Town)

(3) Topography: (Hilly) (Flat) (Level)

(4) Purpose of Well: Domestic
 (Domestic Irrigation, Municipal, Industrial, Other)

| Description & Color of Materials Sand, Clay, Red Clay, Shell, etc. | Thick-ness Feet | Depth Feet |
|-----------------------------------------------------------------------|-----------------|------------|
| <u>Clay</u> | <u>30</u> | <u>30</u> |
| <u>sand & gravel</u> | <u>33</u> | <u>63</u> |
| <u>expanding sand</u> | <u>10</u> | <u>73</u> |
| | | |
| | | |
Information upon completion of well:

(1) Diameter 2 inches.

(2) Total Depth 73 feet.

(3) Water Level 40 feet below top of ground.

(4) Cased to 73, Size 2.


(5) Screen: Size 1 1/4, Length 6.

(6) Were any formations sealed against pollution?
 yes, no.

If YES depth of formation _____.

Why _____.

Drillers Remarks: _____

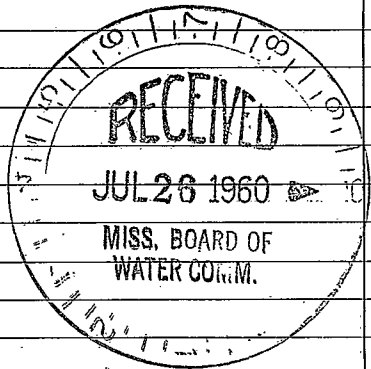

(Use Back Side)

Well No.

