

TALLA.

F 8  
5-16-62

WATER WELL DRILLERS LOG

Tallahatchie

Date: 5/16, 1962, Driller: Jas. R. Lips

County: Panola

(Name)

(1) Owner of Land: Geo. W. Smith  
(Name)  
Charleston, Miss  
(Address)

Description & Color of Materials Sand, Clay, Red Clay, Shell, etc.	Thick- ness Feet	Depth Feet
top soil & clay	0	10
clay	10	25
dark sand	25	40
light sand	10	50

(2) Location: 1/4, 1/4, Sec. 14 T. 25 N. R. 2 E  
3 miles No of Charleston  
(distance) (direction) (Nearest Town)

(3) Topography: Hilly  
(Hilly) (Flat) (Level)


(4) Purpose of Well: Domestic  
(Domestic Irrigation  
Municipal, Industrial, Other)

Information upon completion of well:

- (1) Diameter 2 inches.
- (2) Total Depth 50 feet.
- (3) Water Level 35 feet below top of ground.
- (4) Cased to 42, Size 2"
- (5) Screen: Size 1 1/4, Length 6'
- (6) Were any formations sealed against pollution?  
\_\_\_\_\_ yes,  no.

If YES depth of formation \_\_\_\_\_  
Why \_\_\_\_\_

Drillers Remarks: \_\_\_\_\_  
\_\_\_\_\_  
\_\_\_\_\_

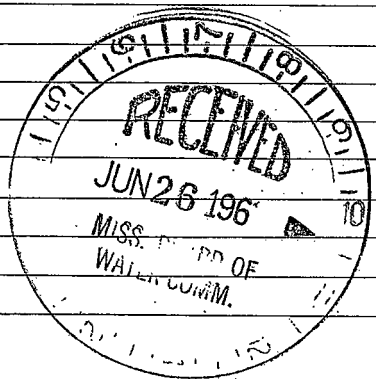

(Use Back Side)

Retain this copy for your office files.

Well No.

1912

...

...

