

TALLA.

MISSISSIPPI BOARD OF WATER COMMISSIONERS

F. 9

9-5-62

WATER WELL DRILLERS LOG

CODED


Date: 9/5, 1962, Driller: James R. Lipe County: Pontchartraine  
(Name)

	Description & Color of Materials Sand, Clay, Red Clay, Shell, etc.	Thick- ness Feet	Depth Feet
(1) Owner of Land: Jimmie Barnes (Name) Charlotten Miss (Address)	Top Soil	0	25
(2) Location: 1/4, 1/4, Sec 34 T25 R2 1 miles No. east of Charleston (distance) (direction) (Nearest Town)	Soft clay Gravel Sand & clay Sand	25 65 100 125	65 100 125 135
(3) Topography: Hilly (Hilly) (Flat) (Level)			
(4) Purpose of Well: Domestic (Domestic Irrigation Municipal, Industrial, Other)			

Information upon completion of well:

- (1) Diameter 2 inches.
- (2) Total Depth 135 feet.
- (3) Water Level 100 feet below top of ground.
- (4) Cased to 135, Size 2
- (5) Screen: Size 1 1/4, Length 6"
- (6) Were any formations sealed against pollution?  
 yes,  no.

If YES depth of formation Sealed  
Why 10' at top of well  
Drillers Remarks:

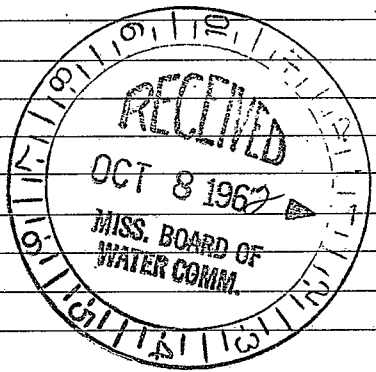

(Use Back Side)

Well No.

