

WATER WELL DRILLERS LOG

Tallahatchie

TALLA.
Date: Jan 28, 1964
L 1-8-64

Driller: James R. Lyle
(Name)

County Penola

- (1) Owner of Land: Mrs. M.T. Neek
(Name)
Charleston
(Address)
- (2) Location: $\frac{1}{4}$, $\frac{1}{4}$, Sec. 15, T. 24, R. 2
4 miles So., of Charleston
(distance) (direction) (Nearest Town)
- (3) Topography: Hilly
(Hilly) (Flat) (Level)
- (4) Purpose of Well: Domestic
(Domestic Irrigation
Municipal, Industrial, Other)

Description & Color of Materials Sand, Clay, Red Clay, Shell, etc.	Thick- ness Feet	Depth Feet
<u>Clay</u>	<u>0</u>	<u>20</u>
<u>Clay & gravel</u>	<u>20</u>	<u>35</u>
<u>Gravel</u>	<u>35</u>	<u>45</u>
<u>Gravel & Sand</u>	<u>45</u>	<u>53</u>
<u>Up-sand</u>	<u>53</u>	<u>74</u>


Information upon completion of well:

- (1) Diameter 2 inches.
- (2) Total Depth 74' feet.
- (3) Water Level 40 feet below top of ground.
- (4) Cased to 63', Size 2"
- (5) Screen: Size 6 1/4", Length 6'
- (6) Were any formations sealed against pollution?
yes, no.

If YES depth of formation _____

Why _____

Drillers Remarks: _____

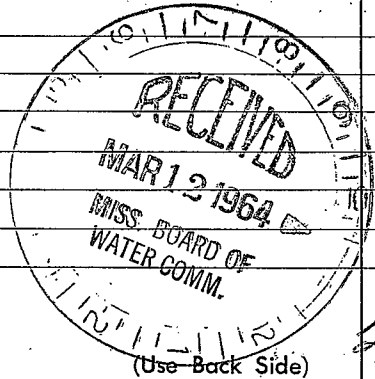

Well No. 21

Retain this copy for your office files.

WATER WELL DRILLERS

Date: _____, 19____, Driller: _____ County _____
(Name)

	Description & Color of Materials Sand, Clay, Red Clay, Shell, etc.	Thick- ness Feet	Depth Feet
(1) Owner of Land: _____ <small>(Name)</small> _____ <small>(Address)</small>			
(2) Location: _____ ¼, _____ ¼, Sec. _____ T _____ R _____, _____ miles _____, of _____, <small>(distance) (direction) (Nearest Town)</small>			
(3) Topography: _____ <small>(Hilly) (Flat) (Level)</small>			
(4) Purpose of Well: _____ <small>(Domestic Irrigation Municipal, Industrial, Other)</small>			
Information upon completion of well:			
(1) Diameter _____ inches.			
(2) Total Depth _____ feet.			
(3) Water Level _____ feet below top of ground.			
(4) Cased to _____, Size _____,			
(5) Screen: Size _____, Length _____.			
(6) Were any formations sealed against pollution? _____ yes, _____ no.			
If YES depth of formation _____			
Why _____			
Drillers Remarks: _____			

Well No.

(Use Back Side)

tain this copy for your office files.