

TALLA.

F 11

4-24-65

MISSISSIPPI BOARD OF WATER COMMISSIONERS

CODED

WATER WELL DRILLERS LOG

Date: 4.24, 1965, Driller: ^{pipe} Frank Taylor County Tallahatchie (Name)

(1) Owner of Land: Roy H. Tatum
(Name)
Charleston
(Address)

(2) Location: 1/4, 1/4, Sec. 16 ²⁵² ~~252~~ ₂₅₂ ²⁵² ~~252~~ ₂₅₂
6 miles S.W. of Charleston
(distance) (direction) (Nearest Town)

(3) Topography: Hilly
(Hilly) (Flat) (Level)

(4) Purpose of Well: Domestic
(Domestic Irrigation
Municipal, Industrial, Other)

Description & Color of Materials Sand, Clay, Red Clay, Shell, etc.	Thick- ness Feet	Depth Feet
Red clay	0	23
" " "	23	43
Sand and clay	43	63
cc r gravel	63	83
sand	83	103
water sand	103	119

Information upon completion of well:

(1) Diameter 4 inches.

(2) Total Depth 119 feet.

(3) Water Level 80 feet below top of ground.


(4) Cased to 113, Size 4"

(5) Screen: Size 4", Length 6'

(6) Were any formations sealed against pollution?
_____ yes, _____ no.

If YES depth of formation _____
Why _____

Drillers Remarks: _____

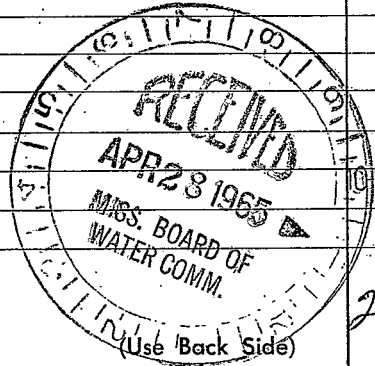

Well No. 26

