

TALLAHATCHIE
 F 19
 1-30-71

MISSISSIPPI
 BOARD OF WATER COMMISSIONERS
 416 North State Street
 Jackson, Mississippi 39201

CODED

WATER WELL DRILLERS LOG

1-30 1971 James R. Lipe Tallahatchie
 date well completed firm name county well located

LANDOWNER:	description of formations encountered	from	to
STEWART	Denham clay	0	20
Charleston Miss. (mailing address)	" Sand	20	40
	" "	40	60
	" "	60	80
	" "	80	100
WELL LOCATION: sec. 34 T 25 N R 2 E S W	Travel	100	120
0 miles west of Charleston (distance) (direction) (nearest town)	" clay	120	140
	" "	140	160
	" "	160	180
	" "	180	200
WELL PURPOSE: HOME (home, irrigation, municipal, industrial)	Sand and clay	200	220
	" " "	220	240
	" " "	240	260
WELL COMPLETION DATA:	clay	260	280
(1) diameter (inches) 2"	" "	280	300
(2) total depth (feet) 587	" "	300	320
(3) static water level (feet) flow below above top of ground.	Sand and clay	320	340
(4) casing PVC 553 (material) (depth)	clay	340	360
2 (size) if telescope see back.	" "	360	380
(5) screen 34 553 (length) (depth to top)	" "	380	400
2 PVC (material)	Sand	400	420
(6) pump flowing 15 (HP) (yield gpm)	clay	420	440
N/A (type power)	" "	440	460
(7) electric log no (yes or no)	Sand	460	480
no (organization running log)	" "	480	500
(8) how well bottom plugged PVC plug	" "	500	520
	Sand	520	587

CODED


MAY 14 1971

MISS. Bd. OF
 WATER COMM.

DRILLERS REMARKS:

If well telescopes please sketch and show depths.

GROUND LEVEL

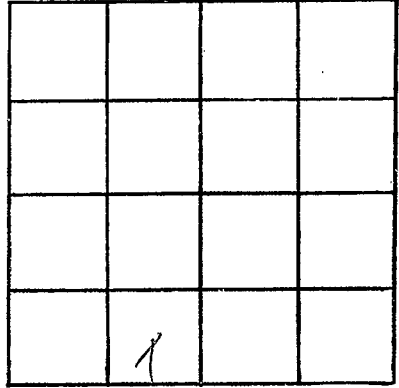

SECTION 34

Please indicate well location X.

ADDITIONAL INFORMATION

If more than one screen,
show locations of each on sketch.