

TALLAHATCHIE
F 20
3-17-71

MISSISSIPPI
 BOARD OF WATER COMMISSIONERS
 416 North State Street
 Jackson, Mississippi 39201

CODED

WATER WELL DRILLERS LOG

3-17 1971 James R. Lipe Tallahatchie
 date well completed firm name county well located

LANDOWNER: Bailey Peters
Charleston Miss.
 (mailing address)

description of formations encountered	from	to
	<u>Clay</u>	<u>0</u>
<u>Sand</u>	<u>20</u>	<u>40</u>
<u>ll</u>	<u>40</u>	<u>60</u>
<u>Clay</u>	<u>60</u>	<u>80</u>
<u>Sand</u>	<u>80</u>	<u>105</u>

WELL LOCATION:
 sec. 14 T. 25 N. R. 2 E.
4 miles North of Charleston
 (distance) (direction) (nearest town)

WELL PURPOSE: Home
 (home, irrigation, municipal, industrial)

- WELL COMPLETION DATA:
- (1) diameter (inches) 4"
 - (2) total depth (feet) 105
 - (3) static water level (feet) 20 below above top of ground.
 - (4) casing PVC 95'
 (material) (depth)
4" if telescope see back.
 (size)
 - (5) screen 10 95'
 (length) (depth to top)
4 PVC
 (size) (material)
 - (6) pump 1/2 8
 (HP) (yield gpm)
Elec.
 (type power)
 - (7) electric log no
 (yes or no)
NI
 (organization running log)
 - (8) how well bottom plugged: PVC
plug

CODED


DRILLERS REMARKS:

MAY 14 1971

MISS. B.D. 616
 WATER COMMISSION

If well telescopes please sketch and show depths.

GROUND LEVEL

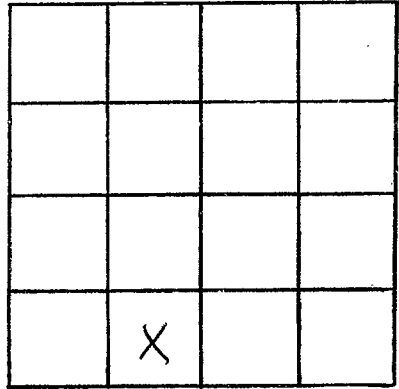

SECTION 14

Please indicate well location X.

ADDITIONAL INFORMATION

If more than one screen, show locations of each on sketch.